

MISSISSIPPI DEPARTMENT OF ENVIRONMENTAL QUALITY

Office of Land and Water Resources

P. O. Box 10631
Jackson, MS 39289-0631

WATER WELL DRILLERS LOG

COUNTY WELL LOCATED Jefferson Sunflower		
WELL NUMBER E	CODED	PERMIT NUMBER
DATE WELL COMPLETED 2006 June 16, 1993		NAME OF DRILLING FIRM McCLAIN

NAME & MAILING ADDRESS OF LANDOWNER Houston Weaver			
P.O. Box 70			
Cleveland, Ms			
WELL LOCATION:	SEC	TOWNSHIP	RANGE
	5	22	4
		N S	E W
DISTANCE	DIRECTION	NEAREST TOWN	
_____ Miles	_____ of	_____	
OTHER LANDMARK			
WELL PURPOSE: Home, Irrigation, Municipal, Industrial, Fish Pond, etc.			

PUMP DATA		
PUMP TYPE (Circle One): Submersible, Turbine , Jet, Flowing Well, Other (Describe) _____		
POWER TYPE (Circle One): Electric, Tractor, Diesel , Gasoline, Butane, Other (Describe) _____ H/P _____		
Pump Capacity (GPM) 1400	No. of Stages 2	Setting Depth 60 FT.
PUMP TEST		
Well yielded _____ GPM with a drawdown of _____ ft. after _____ hours of pumping		

WELL DATA		
Well Depth 107	Casing Diameter (In.) 12	Casing Length (Ft.) 67
Type of Casing PVC	Hole Depth 107	Depth to Static Water Level 33ft.

LOG DATA	
TYPE OF LOG RUN (Circle One): Electric, Gamma Ray, Density, Sonic, Neutron, Other (Describe) _____	
Name of Organization Running Log	


TYPE OF COMPLETION: (Circle One or More):
Gravel Packed, Underreamed, Telescoped,
Natural Development, Open Hole, Other
(Describe) _____

WELL GROUTED TO A DEPTH OF _____ FEET
Type Grout (circle one): Cement, Bentonite, or Mix

GEOLOGIC DATA (Office Use Only)			
Surface Elev.	Geologic Unit	Unit Thickness	Depth to Top
Subs. SWL	Date	Analysis	Aquifer Test

SCREEN DATA		
Diameter - Inches 12	Length - Feet 40	Slot Size - Inches 50
Screen Type PVC	Depth to Bottom - Feet 107	


Driller's Remarks

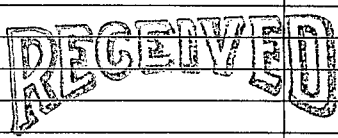DESCRIPTION OF FORMATIONS ENCOUNTERED	FROM	TO	FORMATIONS (Continued)	FROM	TO
Top soil	0	17	 JUL 09 1993 Dept. of Environmental Quality Office of Land & Water Resources		
fine sand + clay	17	60			
course sand + gravel	60	105			
fine sand	105	110			

IF MORE SPACE IS NEEDED, USE BACK

If well telescopes please
sketch and show depths.

GROUND LEVEL

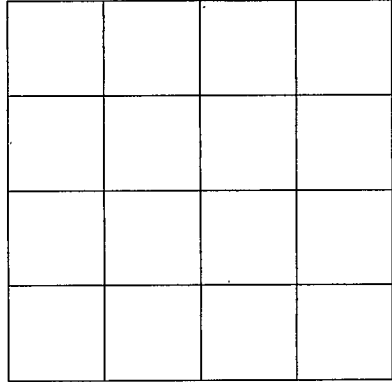

SECTION _____

Please indicate well location X.

ADDITIONAL INFORMATION

If more than one screen,
show location of each on sketch.