


per W. Oakley
 JRM
 8-31-68

Sunflower
 F 11
 10-68
 WSGS

MISSISSIPPI
 BOARD OF WATER COMMISSIONERS
 416 North State Street
 Jackson, Mississippi 39201

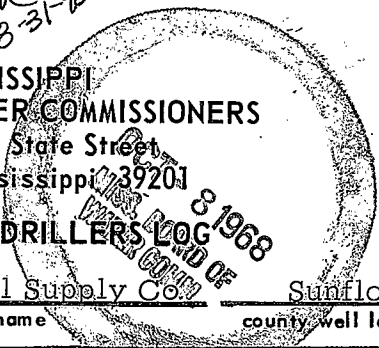


WATER WELL DRILLERS LOG

October 19 68 Carloss Well Supply Co Sunflower
 date well completed firm name county well located

LANDOWNER:	description of formations encountered	from	to
Town of Ruleville	Gumbo	0	20
Ruleville, Mississippi	Fine Sand	20	60
(mailing address)	Coarse Sand & Gravel	60	110
WELL LOCATION:	Rock-Conglomerant	110	111
sec. 31 T. 22 N R. 3 <input checked="" type="checkbox"/> W	Sand & Gravel	111	122
(distance) miles (direction) of (nearest town)	Clay w/Strks Sand	122	187
WELL PURPOSE: Municipal	Brown Sand-Lignite	187	211
(home, irrigation, municipal, industrial)	Thin Layers Rock	211	218
WELL COMPLETION DATA:	Sand Lignite	218	368
(1) diameter (inches) 10"	Hard Clay	368	413
(2) total depth (feet) 1357'	Hard Rock	413	414
(3) static water level (feet) +5' above top of ground.	Hard Clay	414	465
(4) casing Blk. Stl. 1265' (material) (depth)	Sand	465	472
No/ (size) if telescope see back.	Sand w/Strks Clay	472	502
(5) screen 80' 1276' (length) (depth to top)	Very Hard Packed Sand	502	622
6" Stainless Steel (size) (material)	Hard Clay	622	652
(6) pump 30 500 (HP) (yield gpm)	Very Hard Clay	652	714
Electric (type power)	Sandy Clay	714	740
(7) electric log Yes (yes or no)	Hard Clay	740	741
U.S.G.S. WRD (organization running log)	Green Sand	741	777
(8) how well bottom plugged B.P. Valve	Sand, Layers Rock & Clay	777	808
DRILLERS REMARKS:	Green Sand w/Rock	808	838
"AS USUAL" --	Sandy Shale	838	868
A FINE CARLOSS WELL"	Clay	868	899
	Very Hard Clay	899	910
	Sandy Shale-Strk Rock	910	991
	Sandy Shale	991	1072
	Very Hard Clay	1072	1125
	Sandy Clay	1125	1223
	Very Hard Fine Sand	1223	1254
	Clay w/Strks Sand	1254	1274
	Sand	1274	1360
	Clay w/Strks Sand	1360	1371
	Clay, Sand, Rock	1371	1412

If well telescopes please
sketch and show depths.

GROUND LEVEL

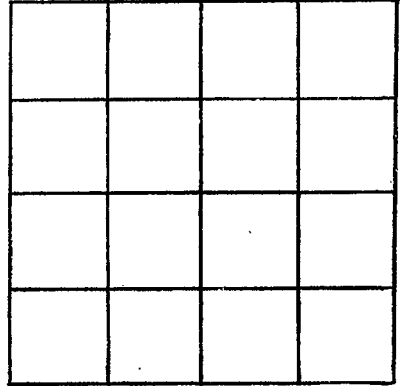

SECTION _____

Please indicate well location X.

ADDITIONAL INFORMATION

If more than one screen,
show locations of each on sketch.