

Sunflower  
712  
6-20-68

MISSISSIPPI  
BOARD OF WATER COMMISSIONERS  
416 North State Street  
Jackson, Mississippi 39201

7/23/68  
EOD  
2695

WATER WELL DRILLERS LOG

June 20, 19 68 Layne-Central Company Sunflower  
date well completed firm name county well located

LANDOWNER: Talmadge Clark

description of formations encountered	from	to
Clay	0	46
Big boulders & sand	46	55
Coarse sand, pea gravel and gravel	55	110
Clay		110

Ruleville, Mississippi  
(mailing address)

WELL LOCATION:


sec. 13 T. 22 N R. 3 E  
S W  
6 miles SE of Drew  
(distance) (direction) (nearest town)

WELL PURPOSE: irrigation  
(home, irrigation, municipal, industrial)

WELL COMPLETION DATA:

- (1) diameter (inches) 16"
- (2) total depth (feet) 110'
- (3) static water level (feet) 16' below top of ground.
- (4) casing steel, 60' (material), (depth)  
16" if telescope see back. (size)
- (5) screen 50' , 110' (length) , (depth to top)  
16" , Armco (size) , (material)
- (6) pump 70 2400 (HP) (yield gpm)  
engine (type power)
- (7) electric log no (yes or no)  
(organization running log)
- (8) how well bottom plugged plate

DRILLERS REMARKS:

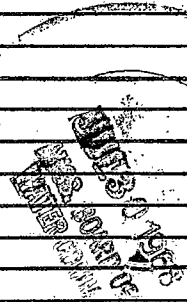

If well telescopes please sketch and show depths.

GROUND LEVEL


SECTION 13

Please indicate well location X.

ADDITIONAL INFORMATION

If more than one screen,  
show locations of each on sketch.