

Sunflower
F 13
6-4-70

MISSISSIPPI
BOARD OF WATER COMMISSIONERS
416 North State Street
Jackson, Mississippi 39201

CODED

WATER WELL DRILLERS LOG

DYER WELL & IRRIGATION SERVICE Sunflower

6-4-70 19
date well completed

firm name

county well located

LANDOWNER:

R.W. Atkinson

Drew, Miss.
(mailing address)

description of formations encountered

from to

Clay	0	23
Fine Sand + Blue Clay	23	33
Medium Sand	33	63
Sand + Gravel	63	103

WELL LOCATION:

sec. 2 T 22 N R 3 E
3 miles E of Drew
(distance) (direction) (nearest town)

WELL PURPOSE: FRR
(home, irrigation, municipal, industrial)

WELL COMPLETION DATA:

- (1) diameter (inches) 12"
- (2) total depth (feet) 103
- (3) static water level (feet) 18 below top of ground.
- (4) casing Steel 63
(material) (depth)
12" if telescope see back.
(size)
- (5) screen 40' 63"
(length) (depth to top)
12" Steel
(size) (material)
- (6) pump 60 1600
(HP) (yield gpm)
Diesel Tractor
(type power)
- (7) electric log No
(yes or no)

(organization running log)

(8) how well bottom plugged Plate

CODED

JUN 30 1970


MISS. BD. OF

WATER

DRILLERS REMARKS:

If well telescopes please sketch and show depths.

GROUND LEVEL

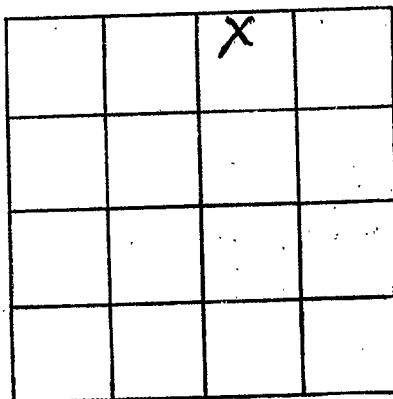

SECTION 2

Please indicate well location X.

ADDITIONAL INFORMATION

Lined area for additional information.

If more than one screen, show locations of each on sketch.