

Sunflower  
F14  
7-7-70

MISSISSIPPI  
BOARD OF WATER COMMISSIONERS  
416 North State Street  
Jackson, Mississippi 39201  
WATER WELL DRILLERS LOG

CODED 7/17/70  
C3238

July 7, 1970 Layne-Central Company Sunflower  
date well completed firm name county well located

LANDOWNER: Talmadge Clark	description of formations encountered	from	to
Ruleville, Mississippi (mailing address)			
WELL LOCATION:	Sand	14	30
sec. 13 T 22 N R 3	Coarse sand	30	46
(distance) miles (direction) of (nearest town)	Coarse sand & pea gravel	46	75
WELL PURPOSE: Irrigation (home, irrigation, municipal, industrial)	Coarse sand & gravel	75	109
WELL COMPLETION DATA:			
(1) diameter (inches) 12"			
(2) total depth (feet) 109'			
(3) static water level (feet) 18' below top of ground.			
(4) casing steel, 69' (material) (depth)			
12" (size) if telescope see back.			
(5) screen 40' (length), 109' (depth to top)			
12" (size), Armco (material)			
(6) pump 40 (HP), 1000 (yield gpm)			
engine (type power)			
(7) electric log no (yes or no)			
(organization running log)			
(8) how well bottom plugged plate			
DRILLERS REMARKS:			


CODED

JUL 23 1970

MISS. BD. OF  
WATER COMMISSIONERS

If well telescopes please sketch and show depths.

GROUND LEVEL

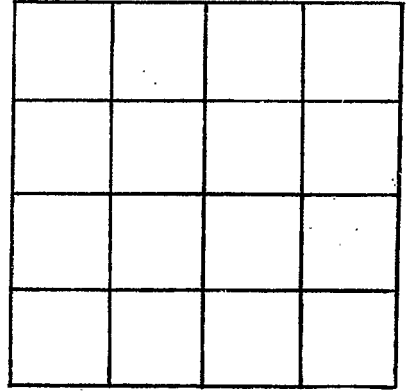

SECTION \_\_\_\_\_

Please indicate well location X.

ADDITIONAL INFORMATION

If more than one screen,  
show locations of each on sketch.