

SUNFLOWER  
F15  
7-24-70

MISSISSIPPI  
BOARD OF WATER COMMISSIONERS  
416 North State Street  
Jackson, Mississippi 39201

CODED

WATER WELL DRILLERS LOG

7-24-70<sup>19</sup> DYER WELL & IRRIGATION SERVICE Sunflower  
date well completed firm name county well located

LANDOWNER: North Sunflower  
County Educational Foundation  
Drew, Miss.  
(mailing address)

WELL LOCATION:  
sec. 24 T 22 N R 3 W  
3 miles SO. of DREW  
(distance) (direction) (nearest town)

WELL PURPOSE: SCHOOL  
(home, irrigation, municipal, industrial)

WELL COMPLETION DATA:  
(1) diameter (inches) 4 x 2 1/2  
(2) total depth (feet) 106 1/2  
(3) static water level (feet) 20 below above  
top of ground.  
(4) casing Steel, 1035,  
(material) (depth)  
4 x 2 1/2 if telescope see back.  
(size)  
(5) screen 30', 1035  
(length) (depth to top)  
2 1/2", Stainless Steel  
(size) (material)  
(6) pump 3 50  
(HP) (yield gpm)  
Elec.  
(type power)  
(7) electric log NO  
(yes or no)  
(organization running log)  
(8) how well bottom plugged Back  
Pressure Valve

description of formations encountered	from to	
CLAY	0	18
SAND	18	60
SAND + GRAVEL	60	170
CLAY	170	200
SAND + SLTALC	200	380
CLAY	380	430
SAND + SLTALC	430	560
SAND	560	840
SAND + SLTALC	840	1057
SAND	1057	1065


CODED

DRILLERS REMARKS:

AUG 4 1970

If well telescopes please sketch and show depths.

GROUND LEVEL

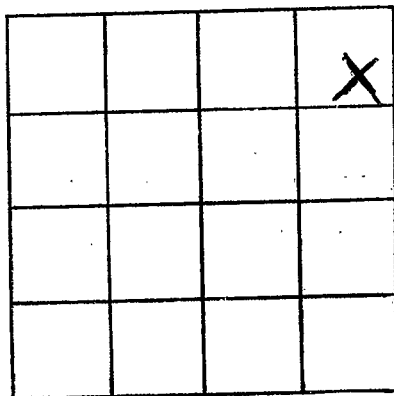

SECTION 24

Please indicate well location X.

ADDITIONAL INFORMATION

If more than one screen,  
show locations of each on sketch.