

SUNFLOWER

F16

9-24-70

MISSISSIPPI BOARD OF WATER COMMISSIONERS 416 North State Street Jackson, Mississippi 39201

CODED

WATER WELL DRILLERS LOG

DYER WELL & IRRIGATION SERVICE SUNFLOWER

9-24-70 19 date well completed

firm name

county well located

LANDOWNER:

FLETCHER CLARK

description of formations encountered

from

to

DREW, MISS

CLAY SAND & GRAVEL

0 38 38 82

(mailing address)

WELL LOCATION:

sec. 16 T. 22 N. R. 3 W. 2 miles S.E. of DREW (distance) (direction) (nearest town)

WELL PURPOSE: IND. IRR. (home, irrigation, municipal, industrial)

WELL COMPLETION DATA:

- (1) diameter (inches) 4"
(2) total depth (feet) 82'
(3) static water level (feet) 17' below top of ground.
(4) casing (material) 4" BUR. 72' (depth)
(5) screen 10' 72' (length) (depth to top)
(6) pump 1 30 (HP) (yield gpm)
(7) electric log 110 (yes or no)
(organization running log)
(8) how well bottom plugged B.P. VALUE

CODED


NOV 23 1970

DRILLERS REMARKS: SCREEN CONNECTED WITH 4" X 3" SWEDGE NIPPLE

MIS- DR

If well telescopes please sketch and show depths.

GROUND LEVEL

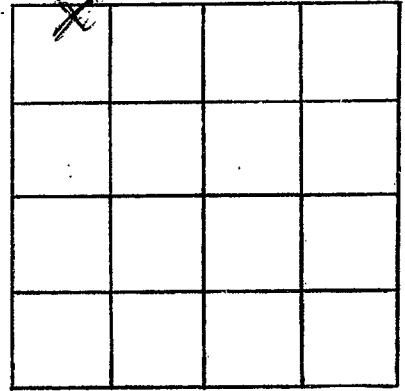

SECTION 16

Please indicate well location X.

ADDITIONAL INFORMATION

If more than one screen,
show locations of each on sketch.