

SUNFLOWER

F17

12-1-70

MISSISSIPPI BOARD OF WATER COMMISSIONERS
416 North State Street
Jackson, Mississippi 39201

CODED

WATER WELL DRILLERS LOG

12/1/70 date well completed 19 20 D. Blue Well & Supply Sunflower firm name county/well located

LANDOWNER: J. W. Wampler

Rt 2 Box 47
Ridville, Miss.
(mailing address)

description of formations encountered

from to

Clay	0	18
Sand + P. gravel	18	151
Clay	151	152
FINE SAND	152	230
Clay	230	235
SAND	235	282
Clay + shale	282	465
SAND	465	530
Clay	530	535
shale	535	648
SAND (GRAVEL Sand + rocks)	648	750

WELL LOCATION:

sec. 27 T. 22 N. R. 3 E
1 1/2 miles West of Ridville
(distance) (direction) (nearest town)

WELL PURPOSE: Home
(home, irrigation, municipal, industrial)

WELL COMPLETION DATA:

- (1) diameter (inches) 4" x 2"
- (2) total depth (feet) 525
- (3) static water level (feet) _____ below/above top of ground.
- (4) casing Galv. (material), _____ (depth)
- _____ (size) if telescope see back.
- (5) screen 20 (length), _____ (depth to top)
2" (size), Stainless Steel (material)
- (6) pump 1/2 (HP), _____ (yield gpm)
Elec (type power)
- (7) electric log No (yes or no)

(organization running log)

(8) how well bottom plugged B/walsh

DRILLERS REMARKS: No rock



CODED

DEC 10 1970

MISS. BD. OF WATER COMM.

If well telescopes please sketch and show depths.

GROUND LEVEL

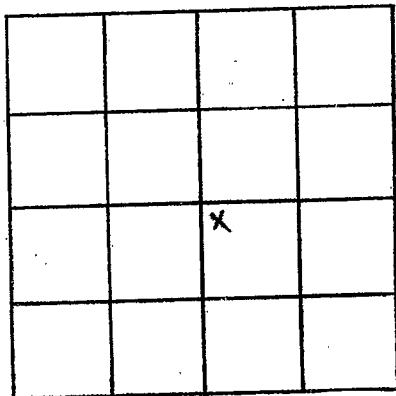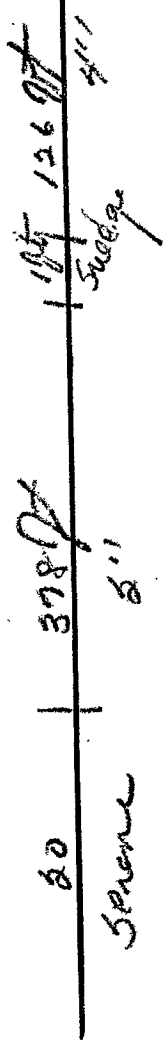

SECTION 27

Please indicate well location X.

ADDITIONAL INFORMATION

If more than one screen, show locations of each on sketch.