

SUNF. MISSISSIPPI BOARD OF WATER COMMISSIONERS

F 19

5-23-58

WATER WELL DRILLERS LOG

CODED

10/1/65
#528

Date: May 23, 1958, Driller: Layne-Central Company County Sunflower

(Name)

(1) Owner of Land: <u>Brooks Farming Company</u> (Name)	Description & Color of Materials Sand, Clay, Red Clay, Shell, etc.	Thick- ness Feet	Depth Feet
<u>Drew, Mississippi</u> (Address)	Clay	15	15
	Fine blue sand	18	33
(2) Location: <u>1/4, 1/4, Sec. 1</u> <u>22R3</u>	Medium blue sand	14	47
<u>6</u> miles <u>east</u> of <u>Drew</u> (distance) (direction) (Nearest Town)	Coarse sand	15	62
(3) Topography: _____ (Hilly) (Flat) (Level)	Coarse sand, lignite & pea rock.	20	82
(4) Purpose of Well: <u>irrigation</u> (Domestic Irrigation Municipal, Industrial, Other)	Sand & pea rock	10	92
	Coarse sand & pea rock	10	102
	Sand & gravel	9	111


Information upon completion of well:

- (1) Diameter 16x12 inches.
- (2) Total Depth 111 feet.
- (3) Water Level 14' 7" feet below top of ground.
- (4) Cased to 59' Size 16"
2' of 16" x 12" S wage
- (5) Screen: Size 12", Length 50'
- (6) Were any formations sealed against pollution?
_____ yes, _____ no no.

If YES depth of formation _____
Why _____

Drillers Remarks: _____
2500 GPM.
Engine drive.

CODED

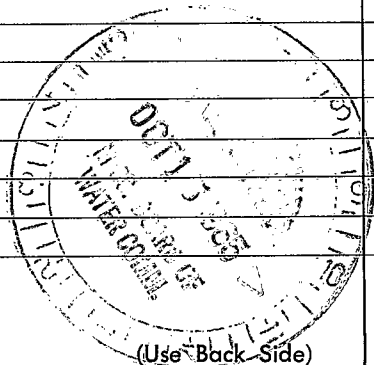

Well No.

