

**SUNFLOWER**  
**F 26**  
**4-10-73**

MISSISSIPPI  
 BOARD OF WATER COMMISSIONERS  
 416 North State Street  
 Jackson, Mississippi 39201

**CODED**

**WATER WELL DRILLERS LOG**

4/10 1973 date well completed  
 Delta Well Supply Sunflower firm name  
 county well located

**LANDOWNER:**

W. H. Starnes  
 Rt 2-Box 72 - Ruleville Miss.  
 (mailing address)

**description of formations encountered**

from to

Top Soil	0	18
Clay	18	50
Shale & sand	50	148
Clay	148	320
Sand	320	345
Shale & Clay	345	524
Sand	524	575
Clay	575	588

**WELL LOCATION:**

sec 27 T 22 N R 3 E  
 3 miles East Ruleville  
 (distance) (direction) (nearest town)

**WELL PURPOSE:**  
 (home, irrigation, municipal, industrial)

Home  
 Set @ 567

**WELL COMPLETION DATA:**

- (1) diameter (inches) 4x2
- (2) total depth (feet) 567
- (3) static water level (feet) 26 below top of ground.
- (4) casing gal. pipe (material) (depth) (size) if telescope see back.
- (5) screen 80 ft (length) (depth to top) 2" (size) (material)
- (6) pump 1 (HP) 19 (yield gpm) elec (type power)
- (7) electric log 7/0 (yes or no)

**CODED**



(organization running log)

(8) how well bottom plugged @ P Valve

**DRILLERS REMARKS:**

If well telescopes please sketch and show depths.

GROUND LEVEL

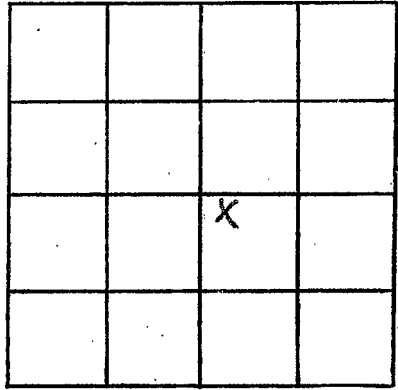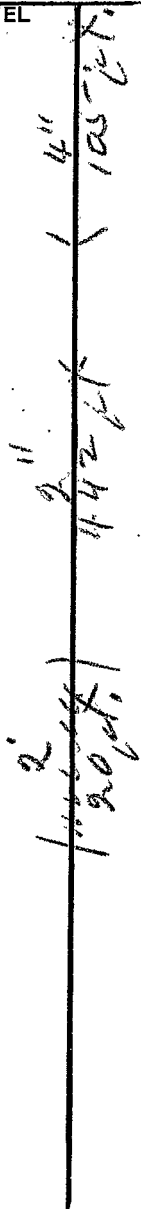

SECTION 27

Please indicate well location X.

ADDITIONAL INFORMATION

A series of horizontal lines for providing additional information, currently blank.

If more than one screen, show locations of each on sketch.