

SUNF. MISSISSIPPI BOARD OF WATER COMMISSIONERS

F 20 33  
2-22-62

for work  
JMM  
8-31-62

WATER WELL DRILLERS LOG

**CODED**

Date: 2-22-1962, Driller: Layne-Central Co. County: SUNFLOWER

(Name)

(1) Owner of Land: Nat'l Compress Co.  
(Name)  
Drew, Mississippi  
(Address)

(2) Location: 1/4, 1/4, Sec. 8 T22R3  
\_\_\_\_\_ miles \_\_\_\_\_ of \_\_\_\_\_  
(distance) (direction) (Nearest Town)

(3) Topography: \_\_\_\_\_  
(Hilly) (Flat) (Level)

(4) Purpose of Well: Compress  
(Domestic Irrigation  
Municipal, Industrial, Other)

Information upon completion of well:

(1) Diameter 8" inches.

(2) Total Depth 1274'2" feet.

(3) Water level 9 plus feet below top of ground.

(4) Cased to 1237', Size 8"

(5) Screen: Size 6", Length 22' 1"

(6) Were any formations sealed against pollution?  
 yes, \_\_\_\_\_ no.


If YES depth of formation 1237'

Why \_\_\_\_\_ required

Drillers Remarks: \_\_\_\_\_

| Description & Color of Materials<br>Sand, Clay, Red Clay, Shell, etc. | Thick-<br>ness<br>Feet | Depth<br>Feet |
|---|------------------------|---------------|
| clay  | 16                     |               |
| sand and gravel   | 100                    | 116           |
| tough sandy clay  | 44                     | 160           |
| sandy clay  | 58                     | 218           |
| sandy clay  | 46                     | 264           |
| hard sts.   | 5                      | 269           |
| sandy clay  | 51                     | 320           |
| rock  | 1                      | 321           |
| sandy clay  | 89                     | 410           |
| shale   | 80                     | 490           |
| sand  | 8                      | 498           |
| clay  | 4                      | 502           |
| packed sand   | 43                     | 545           |
| sandy shale   | 35                     | 580           |
| packed sand   | 10                     | 590           |
| sand and shale  | 11                     | 601           |
| packed sand   | 12                     | 613           |
| shale   | 38                     | 651           |
| rock  | 2                      | 653           |
| shale   | 17                     | 670           |
| rock  | 3                      | 673           |
| hard sandy shale  | 54                     | 727           |
| shale-boulders  | 21                     | 748           |
| sandy shale   | 42                     | 890           |
| soft sandy shale  | 41                     | 931           |
| hard sandy shale  | 182                    | 1113          |
| fine sandy shale  | 103                    | 1216          |
| sand  | 12                     | 1228          |
| packed sand   | 23                     | 1251          |
| packed sand   | 23                     | 1274          |
| packed sand   | 15                     | 1289          |
| clay  | 2                      | 1291          |

**CODED**

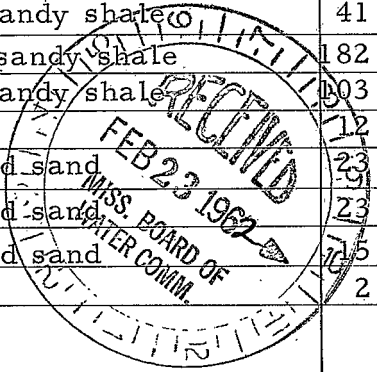

(Use Back Side)

Well No.

