

SUNFLOWER  
F 34  
1-30-74

MISSISSIPPI  
BOARD OF WATER COMMISSIONERS  
416 North State Street  
Jackson, Mississippi 39201

CODED

WATER WELL DRILLERS LOG

January 30, 19 74 Singer-Layne Central Div. Sunflower  
date well completed firm name county well located

LANDOWNER:	description of formations encountered	from	to
Talmadge Clark Ruleville, Mississippi (mailing address)			
	Clay	0	38
	Pea Gravel & Sand	38	70
	Gravel & Sand	70	110
	Clay	110	111
<b>WELL LOCATION:</b>			
sec. 13 T 22 N R 3 E 6 miles SW of Drew (distance) (direction) (nearest town)			
<b>WELL PURPOSE:</b> Irrigation (home, irrigation, municipal, industrial)			
<b>WELL COMPLETION DATA:</b>			
(1) diameter (inches) 16"			
(2) total depth (feet) 110'			
(3) static water level (feet) 12' below above top of ground.			
(4) casing Steel 60' (material) (depth) 16" if telescope see back. (size)			
(5) screen 50' 110' (length) (depth to top) 16" Armco Iron (size) (material)			
(6) pump 70 2400 (HP) (yield gpm) Engine (type power)			
(7) electric log No (yes or no)			
(organization running log)			
(8) how well bottom plugged Plate			
<b>DRILLERS REMARKS:</b>			


CODED

FEB 11 1974

MISS. Bd. of Water Comm.

If well telescopes please sketch and show depths.

GROUND LEVEL

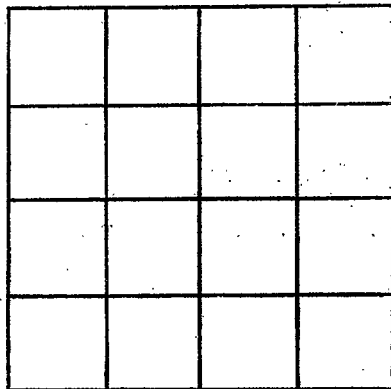

SECTION \_\_\_\_\_

Please indicate well location X.

ADDITIONAL INFORMATION

If more than one screen, show locations of each on sketch.