

SUNFLOWER  
F35  
3/7/78

MISSISSIPPI  
BOARD OF WATER COMMISSIONERS  
416 North State Street  
Jackson, Mississippi 39201

CODED

WATER WELL DRILLERS LOG

MARCH 7, 1978 Deep Well & Irrigation Sunflower  
date well completed firm name county well located

LANDOWNER: <u>L.L. Manning</u>	description of formations encountered	from	to
<u>Drew, Miss. 38737</u> (mailing address)	Clay	0	13
WELL LOCATION: sec. <u>2</u> T. <u>22</u> N R. <u>3</u> E <u>2</u> miles <u>South</u> of <u>Drew</u> (distance) (direction) (nearest town)	Clay	14	23
WELL PURPOSE: <u>Irrigation</u> (home, irrigation, municipal, industrial)	Clay	24	33
WELL COMPLETION DATA: (1) diameter (inches) <u>16"</u>	FINE SAND	34	43
(2) total depth (feet) <u>113'</u>	FINE SAND	44	53
(3) static water level (feet) <u>18'</u> below top of ground.	FINE SAND	54	57
(4) casing <u>Steel</u> , <u>73'</u> (material) (depth)	SAND & GRAVEL	57	113
<u>16"</u> if telescope see back. (size)			
(5) screen <u>40'</u> , <u>73'</u> (length) (depth to top)			
<u>16"</u> , <u>Steel</u> (size) (material)			
(6) pump <u>60</u> <u>3,000</u> (HP) (yield gpm)			
<u>Diesel</u> (type power)			
(7) electric log <u>No</u> (yes or no)			
(organization running log)			
(8) how well bottom plugged <u>Plate</u>			
DRILLERS REMARKS:			

Bottom 113/


Miss. Board of Water Comm.

FEB 8 1979

RECEIVED

If well telescopes please sketch and show depths.

GROUND LEVEL

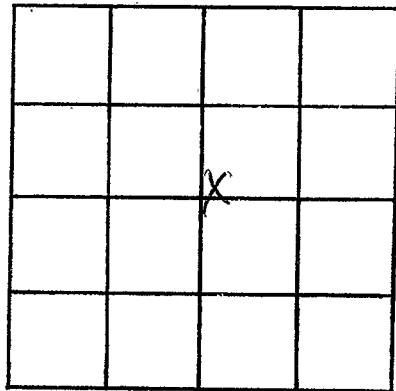

SECTION 2

Please indicate well location X.

ADDITIONAL INFORMATION

If more than one screen, show locations of each on sketch.