

SUNFLOWER
F 36
3-67

WATER WELL DRILLERS LOG

Date: 3-6-67, 19 , Driller: Dyer Well & Irrigator County Sunflower

(Name)

(1) Owner of Land: Travis Parker, Jr.
(Name)
Drew, Miss.
(Address)

(2) Location: SW 1/4, NW 1/4, Sec. 36 (22N) (R36W)
6 miles East of Ruleville
(distance) (direction) (Nearest Town)

(3) Topography: Flat
(Hilly) (Flat) (Level)

(4) Purpose of Well: Irrigation
(Domestic Irrigation
Municipal, Industrial, Other)

Description & Color of Materials Sand, Clay, Red Clay, Shell, etc.	Thick- ness Feet	Depth Feet
0 - 13 Clay		
13 - 23 "		
23 - 33 Fine Sand		
33 - 43 " "		
43 - 53 Coarse Sand & Gravel		
53 - 63 " " "		
63 - 73 " " "		
73 - 83 " " "		
83 - 103 # " "		

Information upon completion of well:

(1) Diameter 16 inches.

(2) Total Depth 97 feet.

(3) Water Level 17 feet below top of ground.


(4) Cased to 57', Size 16 inch.

(5) Screen: Size 16 inch, Length 40'.

(6) Were any formations sealed against pollution?
 yes, X no.

If YES depth of formation _____
Why _____

Drillers Remarks: None

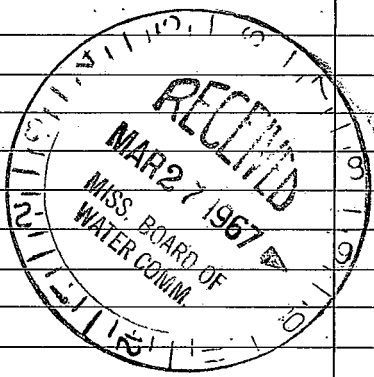

(Use Back Side)

Well No.

