

MISSISSIPPI
 BOARD OF WATER COMMISSIONERS
 416 North State Street
 Jackson, Mississippi 39201

4/14/67
 C 2414

WATER WELL DRILLERS LOG

March 31, 1967 Layne-Central Company Sunflower
 date well completed firm name county well located

LANDOWNER: Brooks Farm- Kelley
 R. Mahan

description of formations encountered	from	to
Clay	0	26
Clay balls	26	45
Coarse sand, gravel	45	89
Coarse sand, pea gravel, big gravel	89	107
Boulders		107

Drew, Mississippi
 (mailing address)


WELL LOCATION:

sec. 1 T 22 N R 3 E
 S W
5 miles east of Drew
 (distance) (direction) (nearest town)

WELL PURPOSE: irrigation
 (home, irrigation, municipal, industrial)

WELL COMPLETION DATA:

- (1) diameter (inches) 16
- (2) total depth (feet) 109
- (3) static water level (feet) 111.7 ^{below} above top of ground.
- (4) casing steel, 59'
 (material) (depth)
16" if telescope see back.
 (size)
- (5) screen 50', 109'
 (length) (depth to top)
16", Armco
 (size) (material)
- (6) pump 70, 2100
 (HP) (yield gpm)
engine
 (type power)
- (7) electric log no
 (yes or no)
 (organization running log)
- (8) how well bottom plugged plate

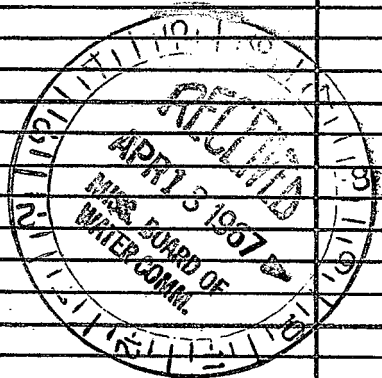

DRILLERS REMARKS:

If well telescopes please sketch and show depths.

GROUND LEVEL

			X

SECTION 1

Please indicate well location X.

ADDITIONAL INFORMATION

If more than one screen, show locations of each on sketch.