

Sunflower
7 38
8-67

MISSISSIPPI
 BOARD OF WATER COMMISSIONERS
 416 North State Street
 Jackson, Mississippi 39201

8/17/67
 [Signature]
 2510

WATER WELL DRILLERS LOG

August 11, 1967 Layne-Central Company Sunflower
 date well completed firm name county well located

LANDOWNER: Brooks Farm - Kelly
R. Mahan

description of formations
 encountered

from to

Drew, Mississippi
 (mailing address)

Clay	0	17
White sand	17	30
Blue clay	30	48
Coarse sand & pea gravel	48	79
Coarse sand & gravel, coarse	79	108
Sand	108	112

WELL LOCATION: SW 1/4 SW 1/4
 sec. 1 T. 22 N R. 3 E
 S W

6 miles east of Drew
 (distance) (direction) (nearest town)


WELL PURPOSE: irrigation
 (home, irrigation, municipal, industrial)

WELL COMPLETION DATA:

- (1) diameter (inches) 16
- (2) total depth (feet) 112
- (3) static water level (feet) 18 ~~528~~ ~~528~~ ~~528~~
 top of ground. ~~above~~
- (4) casing steel, 62'
 (material), (depth)
16" if telescope see back.
 (size)
- (5) screen 50', 112'
 (length), (depth to top)
16" Armco
 (size), (material)
- (6) pump 60 2400
 (HP), (yield gpm)
engine
 (type power)
- (7) electric log no
 (yes or no)
(organization running log)
- (8) how well bottom plugged plate


CODED

DRILLERS REMARKS:

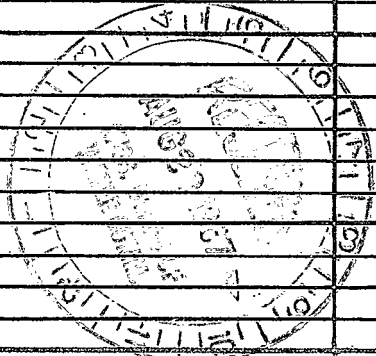

If well telescopes please sketch and show depths.

GROUND LEVEL

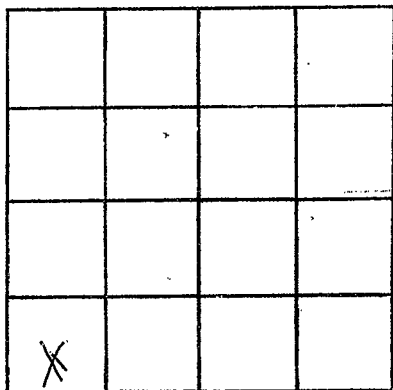

SECTION 1

Please indicate well location X.

ADDITIONAL INFORMATION

If more than one screen,
show locations of each on sketch.