

F 39

10-12-64

WATER WELL DRILLERS LOG

Date: OCT. 12, 1964, Drillers: DELTA DRILLING Co. Co., SUNFLOWER

(Name)

(1) Owner of Land: F. T. CLARK
 (Name)
RULEVILLE, MISS.
 (Address)

(2) Location: NE 1/4, NW 1/4, Sec. 14 T22R3W
 _____ miles _____ of _____
 (distance) (direction) (Nearest Town)

(3) Topography: _____
 (Hilly) (Flat) (Level)

(4) Purpose of Well: DOMESTIC
 (Domestic Irrigation
 Municipal, Industrial, Other)

Description & Color of Materials Sand, Clay, Red Clay, Shell, etc.	Thick- ness Feet	Depth Feet
SANDY LOAM	36	36
SAND	42	78
GRAVEL	55	133
SAND	62	195
GUMBO	96	291
SHALE	40	331
SAND	77	408
SHALE	82	490
SAND	39	529
SHALE	40	569
GUMBO	40	609
SHALE W/ROCKS	86	695
SAND W/ROCKS	81	726
SHALE	60	786
GUMBO W/4" ROCK	31	817
SHALE	38	855
GUMBO	25	880
SAND	63	943
SHALE	35	978
SAND	30	1008
GUMBO	54	1062
SAND	32	1094
GUMBO	42	1136

Information upon completion of well:

(1) Diameter 4 inches.

(2) Total Depth 1136 feet.

(3) Water Level FLOWS feet below top of ground.

(4) Cased to 1079', Size 4" - 108'
3" - 483'
2" - 546'

(5) Screen: Size 2", Length 15' - S.S.
4X3" STEEL REDUCER
3X2" LEAD SEAL

(6) Were any formations sealed against pollution?

_____ yes, _____ no.

If YES depth of formation _____


Why _____

Drillers Remarks: WELL FLOWS - 359PM

HAS 16' LAP OF 2" IN 3" PIPE

WITH 42' - 2" PIPE UNDERNEATH

STRAINER

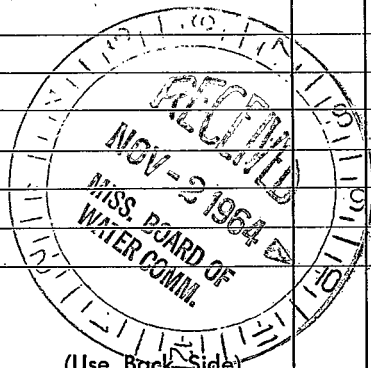

Well No.

WORLD HEADLINE