

Sunflower  
 F 40  
 7-68

MISSISSIPPI  
 BOARD OF WATER COMMISSIONERS  
 416 North State Street  
 Jackson, Mississippi 39201  
 WATER WELL DRILLERS LOG

8/8/68  
 J.P. 2716

July 24, 1968 Layne-Central Com pany Sunflower  
 date well completed firm name county well located

LANDOWNER: Talmadge Clark

description of formations encountered	from	to
Clay	0	17
Fine sand	17	36
Coarse sand	36	70
Coarse sand, pea gravel	70	105
Coarse sand, gravel	105	112


Ruleville, Mississippi  
 (mailing address)

WELL LOCATION: NE 1/4 & NW 1/4  
 sec 24 T 22 N R 3 E  
 S W  
 6 miles southeast of Drew  
 (distance) (direction) (nearest town)

WELL PURPOSE: Irrigation  
 (home, irrigation, municipal, industrial)

WELL COMPLETION DATA:

- (1) diameter (inches) 16
- (2) total depth (feet) 112
- (3) static water level (feet) 17' 6" <sup>below</sup> above top of ground.
- (4) casing steel, 62' (material), (depth)  
 16" If telescope see back.  
 (size)
- (5) screen 50', 112' (length), (depth to top)  
 16", Armco (size), (material)
- (6) pump 70, 2400 (HP), (yield gpm)  
 engine (type power)
- (7) electric log no (yes or no)  
 (organization running log)
- (8) how well bottom plugged plate

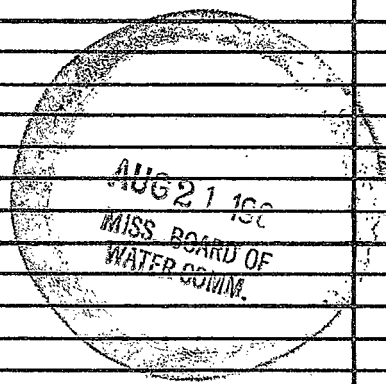

DRILLERS REMARKS:

If well telescopes please sketch and show depths.

GROUND LEVEL


SECTION \_\_\_\_\_

Please indicate well location X.

ADDITIONAL INFORMATION

If more than one screen, show locations of each on sketch.