

CODED

SUNFLOWER
F 42
1-18-75

MISSISSIPPI
BOARD OF WATER COMMISSIONERS
416 North State Street
Jackson, Mississippi 39201

WATER WELL DRILLERS LOG

Sunflower

January 18, 1975 Dyer-Sullivan, Inc. Bolivar
date well completed firm name county well located

LANDOWNER: A.C. Tidemore Sr.
Rt. 1 Box 113
Merigold, Miss.
(mailing address)

description of formations encountered	from	to
	Clay	0
Fine Sand	30	72
SAND + GRAVEL	72	113

WELL LOCATION: 15#
sec. 31 T. 22 N R. 3 E
1/2 miles N of Ruleville
(distance) (direction) (nearest town)

WELL PURPOSE: Irrigation
(home, irrigation, municipal, industrial)

WELL COMPLETION DATA:


- (1) diameter (inches) 16"
- (2) total depth (feet) 113
- (3) static water level (feet) 13 below above top of ground.
- (4) casing BIC Iron, 22' (material) (depth)
16" (size) If telescope see back.
- (5) screen 41' (length), 22' (depth to top)
16 (size), BIC Iron (material)
- (6) pump 100 (HP), 3000 (yield gpm)
DIESEL (type power)
- (7) electric log No (yes or no)
- (organization running log)
- (8) how well bottom plugged Plate

OCT 18 1975

DRILLERS REMARKS: MISS. BD. OF WATER COMMISSIONERS

If well telescopes please sketch and show depths.

GROUND LEVEL

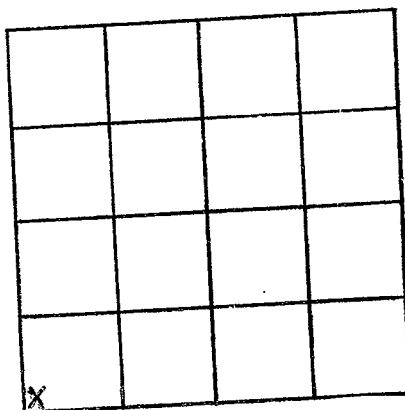

SECTION 31

Please indicate well location X.

ADDITIONAL INFORMATION

If more than one screen, show locations of each on sketch.