

SUNFLOWER

CODED

LEFLORE
F43
4-18-75

MISSISSIPPI
 BOARD OF WATER COMMISSIONERS
 416 North State Street
 Jackson, Mississippi 39201
 WATER WELL DRILLERS LOG

SUNFLOWER
 LeFlore
 Sunflower

April 18, 1975 Dyer-Sullivan, Inc. county well located
 date well completed firm name

LANDOWNER: ED Scott

description of formations encountered	from	to
	Clay	0
Fine SAND	26	74
SAND & GRAVEL	74	114

Minter City, Miss.
(mailing address)

WELL LOCATION:
 sec. 10 T. 22 N R. 3 E Drew
 15H
 4 1/2 miles SW of Private
 (distance) (direction) (nearest town)

WELL PURPOSE: Irrigation
(home, irrigation, municipal, industrial)

WELL COMPLETION DATA:


- (1) diameter (inches) 16"
- (2) total depth (feet) 114'
- (3) static water level (feet) 12' below top of ground.
- (4) casing Blk Iron, 74'
(material) (depth)
16" if telescope see back.
(size)
- (5) screen 40', 74'
(length) (depth to top)
16", Blk Iron
(size) (material)
- (6) pump 100 3000
(HP) (yield gpm)
Electric
(type power)
- (7) electric log No
(yes or no)
- (organization running log)
- (8) how well bottom plugged Flate

DRILLERS REMARKS:

INDEXED
 RECORDED
 OCT 10

If well telescopes please sketch and show depths.

GROUND LEVEL

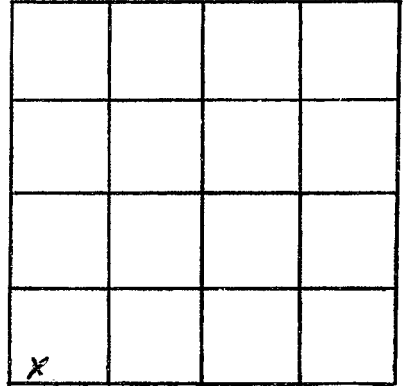

SECTION 10

Please indicate well location X.

ADDITIONAL INFORMATION

If more than one screen, show locations of each on sketch.