

SUNFLOWER
 F 44
 3/31/78

MISSISSIPPI
 BOARD OF WATER COMMISSIONERS
 416 North State Street
 Jackson, Mississippi 39201

WATER WELL DRILLERS LOG

CODED

March 31 1978 Bruce Berryman - Sunflower
 date well completed Green Cove county well located

LANDOWNER: Mr. Jimmy Chandler
 Rt. 1. Box 84
 Ruleville, MS. 38771
 (mailing address)

WELL LOCATION:
 sec. 25 T. 22 N R. 3 W
 6 miles E of Ruleville
 (distance) (direction) (nearest town)

WELL PURPOSE: Home
 (home, irrigation, municipal, industrial)

WELL COMPLETION DATA:

(1) diameter (inches) 4" x 2"
 (2) total depth (feet) 540 ft.
 (3) static water level (feet) 20 ~~feet~~ above
 top of ground blk. - 126 ft.
 (4) casing 2" galv. - 393 ft.
 (material) (depth)
 (size) if telescope see back.
 (5) screen 20 ft., 520 ft.
 (length) (depth to top)
 .010 stainless steel
 (size) (material)
 (6) pump 3 50
 (HP) (yield gpm)
 electric
 (type power)
 (7) electric log No
 (yes or no)
 (organization running log)
 (8) how well bottom plugged B.P.V.

description of formations encountered	from	to
Clay	0	20
Sand	20	60
Sand & Gravel	60	190
Shale	190	300
Sand	300	340
Clay	340	400
Hard Clay	400	430
Hard sand	430	460
Sand	460	540
Clay	540	590


CODED

RECEIVED
 NOV - 7 1978

DRILLERS REMARKS:

If well telescopes please sketch and show depths.

GROUND LEVEL

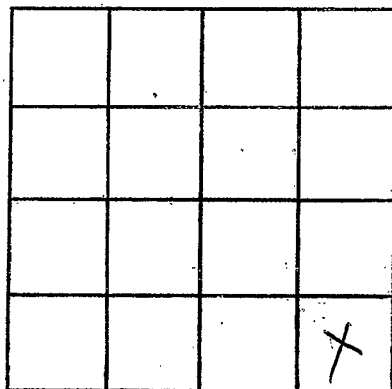

SECTION 25

Please indicate well location X.

ADDITIONAL INFORMATION

If more than one screen,
show locations of each on sketch.