

SUNFLOWER  
F 47  
3/2/78

MISSISSIPPI  
BOARD OF WATER COMMISSIONERS CODED  
416 North State Street  
Jackson, Mississippi 39201  
WATER WELL DRILLERS LOG

MARCH 2 1978 Dyer Well + Irrigation Sunflower  
date well completed firm name county well located

LANDOWNER: DAVID WOODS  
P.O. Box 52  
DREW, MISS. 38737  
(mailing address)

WELL LOCATION:  
sec. 3 T. 22 N. R. 3 E  
2 miles South of DREW  
(distance) (direction) (nearest town)

WELL PURPOSE: Irrigation  
(home, irrigation, municipal, industrial)

- WELL COMPLETION DATA:
- (1) diameter (inches) 12"
  - (2) total depth (feet) 103'
  - (3) static water level (feet) 15' below top of ground.
  - (4) casing Steel, 63',  
(material) (depth)  
12" If telescope see back.  
(size)
  - (5) screen 40', 103'  
(length) (depth to top)  
12", Steel  
(size) (material)
  - (6) pump 40 2000  
(HP) (yield gpm)  
Diesel  
(type power)
  - (7) electric log No  
(yes or no)

(organization running log)

(8) how well bottom plugged None

DRILLERS REMARKS:

description of formations encountered	from	to
Clay	0	13
Clay	14	23
Clay	24	31
FINE SAND	32	64
SAND + GRAVEL	65	103
Broken 103' CODED		


Miss. Board of Water Comm.

FEB 8 1978

RECEIVED

If well telescopes please sketch and show depths.

GROUND LEVEL

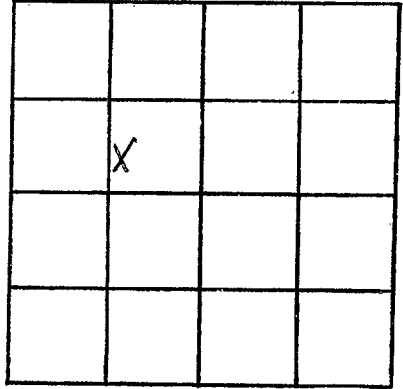

SECTION 2

Please indicate well location X.

ADDITIONAL INFORMATION

If more than one screen,  
show locations of each on sketch.