

MISSISSIPPI DEPARTMENT OF NATURAL RESOURCES
 Bureau of Land and Water Resources
 Southport Mall
 P.O. Box 10631
 Jackson, Mississippi 39209
WATER WELL DRILLERS LOG

CODED

SUNFLOWER
F 52
8-13-80

08/13 1980 Larry's Well & Pump Sunflower
 date well completed firm name county well located

LANDOWNER: Larry Barr
Drew, ms.
 (mailing address)

description of formations encountered	from	to
<u>clay</u>	<u>0</u>	<u>30</u>
<u>fine sand</u>	<u>30</u>	<u>50</u>
<u>best coarse sand</u>	<u>50</u>	<u>100</u>


WELL LOCATION:
 sec. 4 T. 22 N R. 3 E
1 miles E of DREW
 (distance) (direction) (nearest town)

WELL PURPOSE: Drinking Water
 (home, irrigation, municipal, industrial)

- WELL COMPLETION DATA:
- (1) diameter (inches) 10"
 - (2) total depth (feet) 100'
 - (3) static water level (feet) 27 below top of ground.
 - (4) casing steel, 60
 (material) (depth)
 - (size) if telescope see back.
 - (5) screen 40, 60
 (length) (depth to top)
 - 10", steel
 (size) (material)
 - (6) pump 10, 1700
 (HP) (yield gpm)
 - Plastic
 (type power)
 - (7) electric log NO
 (yes or no)


(organization running log)
 (8) how well bottom plugged Steel Plate

DRILLERS REMARKS:

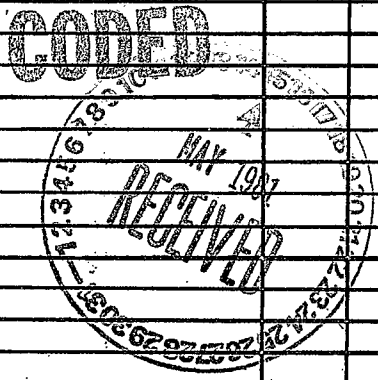

If well telescopes please sketch and show depths.

GROUND LEVEL

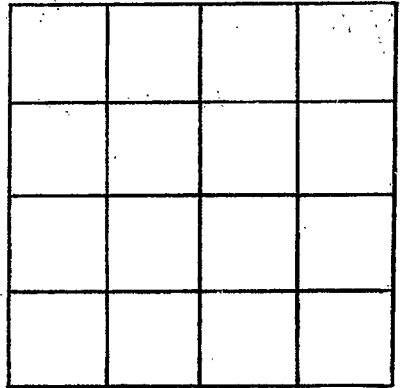

SECTION 4

Please indicate well location X.

ADDITIONAL INFORMATION

If more than one screen, show locations of each on sketch.