

Sunflower
F55
4-2-80

MISSISSIPPI
BOARD OF WATER COMMISSIONERS
416 North State Street
Jackson, Mississippi 39201

CODED

WATER WELL DRILLERS LOG

4/21 19 80 Dyer Sunflower
date well completed firm name county well located

LANDOWNER:	description of formations encountered	from	to
STEVE SHURDEN DREW, MS. (mailing address)	Clay	0	28
WELL LOCATION: sec. 1 T 22 N R 3 E 1 miles SW of Drew (distance) (direction) (nearest town)	Fine Sand	28	34
WELL PURPOSE: <u>Domestic</u> (home, irrigation, municipal, industrial)	Sand	38	48
WELL COMPLETION DATA:	Sand & Gravel	48	706
(1) diameter (inches) <u>16"</u>			
(2) total depth (feet) <u>106'</u>			
(3) static water level (feet) <u>20'</u> below top of ground.			
(4) casing <u>Steel</u> , <u>106'</u> (material) (depth)			
<u>16"</u> if telescope see back. (size)			
(5) screen <u>40'</u> , <u>66'</u> (length) (depth to top)			
<u>16"</u> , <u>Steel</u> (size) (material)			
(6) pump <u>60</u> <u>3000</u> (HP) (yield gpm)			
<u>Diesel</u> (type power)			
(7) electric log <u> </u> (yes or no)			
<u> </u> (organization running log)			
(8) how well bottom plugged <u>plaster</u>			
DRILLERS REMARKS:			


CODED

241

If well telescopes please
sketch and show depths.

0.850

GROUND LEVEL

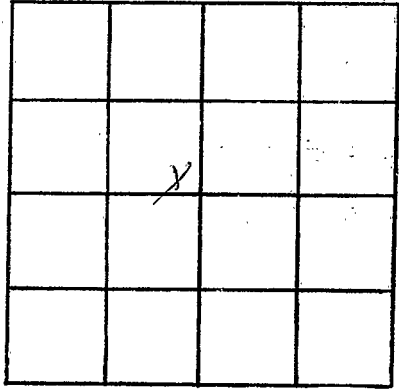

SECTION 1

Please indicate well location X.

ADDITIONAL INFORMATION

Lined area for recording additional information.

If more than one screen,
show locations of each on sketch.