

MISSISSIPPI DEPARTMENT OF NATURAL RESOURCES

Bureau of Land and Water Resources

Southport Mall

P.O. Box 10631

Jackson, Mississippi 39209

WATER WELL DRILLERS LOG

CODED

SUNFLOWER
F57
4-28-81

4-28 1981 date well completed *Deltocrest Supply* firm name *Sunflower* county well located

LANDOWNER:
Ed Scott
Drew Miss.
(mailing address)

description of formations encountered	from	to
<i>Top soil</i>	<i>0</i>	<i>15</i>
<i>fine sand</i>	<i>15</i>	<i>35</i>
<i>coarse sand & gravel</i>	<i>35</i>	<i>114</i>
<i>Bottom</i>	<i>114</i>	


WELL LOCATION:
sec. *10* T. *22* N. R. *3* E. W.
6 miles *East* of *Drew*.
(distance) (direction) (nearest town)

WELL PURPOSE: *Irrigation*
(home, irrigation, municipal, industrial)

WELL COMPLETION DATA:

- (1) diameter (inches) *16*"
- (2) total depth (feet) *114*
- (3) static water level (feet) *27* below above top of ground.
- (4) casing *Steel* (material), _____ (depth),
16" (size) if telescope see back.
- (5) screen *40*' (length), _____ (depth to top),
16" (size), *Steel* (material)
- (6) pump *50* (HP), *2600* (yield gpm),
Diesel (type power)
- (7) electric log *no* (yes or no)
(organization running log) _____
- (8) how well bottom plugged *Steel Pipe*

CODED

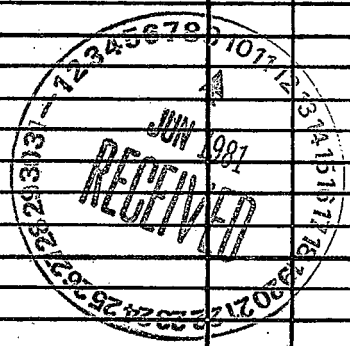

DRILLERS REMARKS:

If well telescopes please sketch and show depths.

GROUND LEVEL


Water Level

27'

12" casing

40' 16" screen

If more than one screen, show locations of each on sketch.

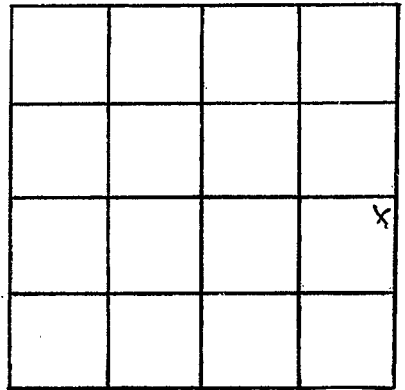

SECTION 10

Please indicate well location X.

ADDITIONAL INFORMATION

Horizontal lines for additional information.