

Bureau of Land and Water Resources

Southport Mall

P.O. Box 10631

Jackson, Mississippi 39202

WATER WELL DRILLERS LOG

CODED

SUNFLOWER

F59

6-5-81

6-5-81

date well completed

Super Well + Turbine

firm name

Sunflower

county well located

LANDOWNER

J. Franum Jr  
Box 274

Ruleville Ms

(mailing address)

WELL LOCATION

21-220 3

3 5 Drw

(elevation)

(direction)

(nearest town)

WELL PURPOSE (drainage, irrigation, industrial)

WELL CONSTRUCTION DATA

(1) casing (inches) 12"

(2) well depth (feet) 93'

(3) static water level (feet) 20' below above top of ground

(4) casing Steel 93'

12' if telescope case back

(5) casing length 40' 53'

12' Steel

(6) pump 60 1500

(HP)

(yield gpm)

diesel

(type power)

(7) electric log (type or no.)

(organization running log)

Handwritten signature

Description of formations encountered

ft.

sand	13	23
sand	23	33
sand	33	43
sand & gravel	43	53
sand & gravel	53	63
gravel	63	73
gravel	73	83
sand & gravel	83	93


CODED

DEPT. OF NATURAL RESOURCES  
BUREAU OF LAND & WATER RESOURCES

JUN 15 1981

RECEIVED

DR.

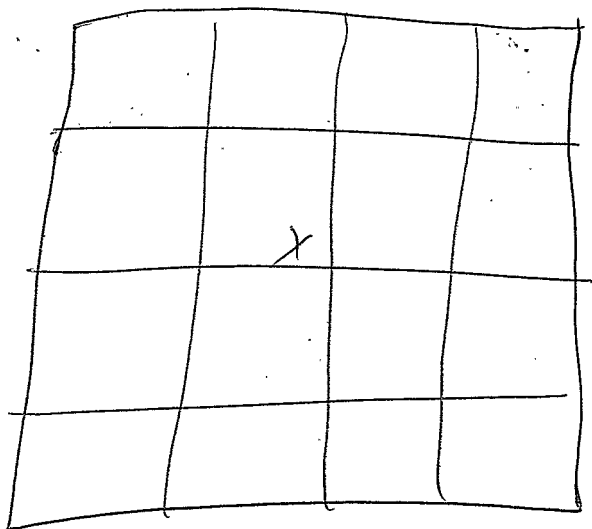

See 21