

MISSISSIPPI DEPARTMENT OF NATURAL RESOURCES

Bureau of Land and Water Resources

Southport Mall

P.O. Box 10631

Jackson, Mississippi 39209 **CODED**

WATER WELL-DRILLERS LOG

Sunflower
F61
625-81

6/25/81 19
date well completed

Oysterhead & Sons, Inc.
firm name

Sunflower
county well located

LANDOWNER: Doyle, Brandon
Rt 1
Releville, Ms. 38771
(mailing address)

WELL LOCATION:
sec. 36 T. 2 N. R. 3 E. S. 5
5 miles E of Releville
(distance) (direction) (nearest town)


WELL PURPOSE:
(home, irrigation, municipal, industrial)

WELL COMPLETION DATA:

- (1) diameter (inches) 16
- (2) total depth (feet) 113
- (3) static water level (feet) 22 below top of ground
- (4) casing # Steel (material) (depth)
- 16 (size) If telescope see back.
- (5) screen 40' 73 (length) (depth to top)
- 16 (size) (material)
- (6) pump 12 300 (HP) (yield gpm)
- (type power)
- (7) electric log (yes or no)
- (organization running log)
- (8) how well bottom plugged None

description of formations encountered	from	to
Clay	13	23
Clay	23	33
Sand	33	43
Sand	43	53
Sand & gravel	53	63
Sand & gravel	63	73
Gravel	73	83
Gravel	83	93
Sand & gravel	93	103
Sand & gravel	103	113


CODED

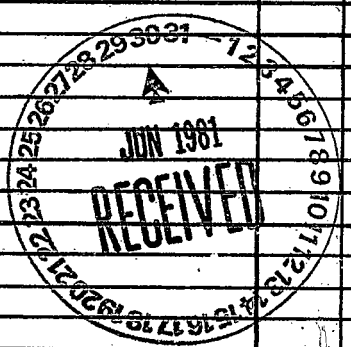

DRILLERS REMARKS:

If well telescopes please sketch and show depths.

GROUND LEVEL

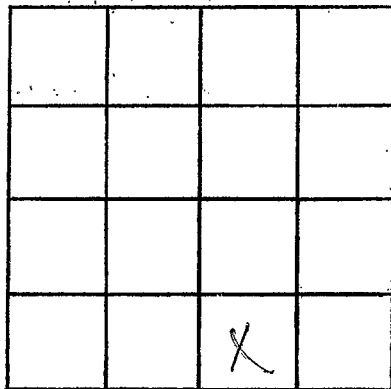

SECTION _____

Please indicate well location X.

ADDITIONAL INFORMATION

If more than one screen,
show locations of each on sketch.