

MISSISSIPPI DEPARTMENT OF NATURAL RESOURCES

Bureau of Land and Water Resources

Southport Mall

P.O. Box 10631

Jackson, Mississippi 39209

WATER WELL DRILLERS LOG


CODED

Simplifier
F62
7-2-81

July 2 1981 Delta Crest Supply Simplifier
 date well completed firm name county well located

LANDOWNER:	description of formations encountered	from	to
<u>W.D. Morlow</u>			
<u>Ruleville Miss</u> (mailing address)	<u>Clay</u>	<u>16</u>	<u>25</u>
	<u>Course sand</u>	<u>25</u>	<u>40</u>
WELL LOCATION:	<u>fine sand</u>	<u>40</u>	<u>60</u>
	<u>Course sand + gravel</u>	<u>60</u>	<u>105</u>
sec. <u>26</u> T. <u>22</u> N. R. <u>3</u> E. W. <u>8</u>	<u>With fine sand streak</u>		
<u>5 mi</u> miles <u>East</u> of <u>Ruleville</u> (distance) (direction) (nearest town)	<u>Clay</u>	<u>105</u>	<u>114</u>
WELL PURPOSE: <u>Domestic</u> (home, irrigation, municipal, industrial)	<u>Bottom out</u>	<u>103</u>	
WELL COMPLETION DATA:			
(1) diameter (inches) <u>16"</u>			
(2) total depth (feet) <u>114</u>			
(3) static water level (feet) <u>28</u> below above top of ground.			
(4) casing <u>Steel</u> (material), _____ (depth), _____ (size) if telescope see back.			
(5) screen <u>40'</u> (length), _____ (depth to top), <u>16"</u> (size), _____ (material)			
(6) pump <u>110</u> (HP), <u>2300</u> (yield gpm), <u>Tractor</u> (type power)			
(7) electric log <u>no</u> (yes or no), _____ (organization running log)			
(8) how well bottom plugged <u>Steel plate</u>			

CODED

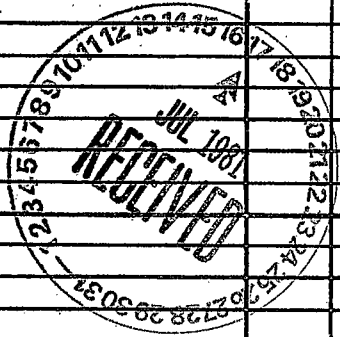

DRILLERS REMARKS:

If well telescopes please sketch and show depths.

GROUND LEVEL

Water Level

28 ft.

1 1/2" Casing

4' 0" ft. 1 1/2" Screen

X			

SECTION 26

Please indicate well location X.

ADDITIONAL INFORMATION

If more than one screen, show locations of each on sketch.