

MISSISSIPPI DEPARTMENT OF NATURAL RESOURCES

Bureau of Land and Water Resources

Southport Mall

P.O. Box 10631

Jackson, Mississippi 39209

WATER WELL DRILLERS LOG

CODED

Sunflower
F 63
8-20-81

8-20-81
 date well completed

Dyer Well
 firm name

SUNFLOWER
 county well located

LANDOWNER:	description of formations encountered	from	to
<u>JOE TRAMM JR</u>			
(mailing address)			
WELL LOCATION: sec. <u>17</u> T <u>20</u> N R. <u>3</u> E S W <u>3</u> miles <u>N</u> of <u>Pulleville</u> (distance) (direction) (nearest town)	<u>Clay</u>	<u>0</u>	<u>36</u>
	<u>fine sand</u>	<u>36</u>	<u>40</u>
	<u>Sand & Gravel</u>	<u>40</u>	<u>48</u>
	<u>fine sand</u>	<u>48</u>	<u>123</u>
WELL PURPOSE: (home, irrigation, municipal, industrial)			
WELL COMPLETION DATA: (1) diameter (inches) <u>12"</u> (2) total depth (feet) <u>123'</u> (3) static water level (feet) <u>23'</u> below above top of ground. (4) casing <u>Steel</u> , <u>83</u> , (material) (depth) <u>16"</u> if telescope see back. (size) (5) screen <u>40</u> , <u>83</u> (length) (depth to top) <u>16"</u> , <u>Steel</u> (size) (material) (6) pump <u>40</u> <u>2000</u> (HP) (yield gpm) <u>Diesel</u> (type power) (7) electric log <u>no</u> (yes or no) (organization running log) (8) how well bottom plugged <u>plate</u>			
DRILLERS REMARKS:			

CODED
 MISSISSIPPI DEPARTMENT OF NATURAL RESOURCES
 BUREAU OF LAND & WATER RESOURCES


AUG 26 1981

RECEIVED

AUG 1981
RECEIVED
 MISSISSIPPI DEPARTMENT OF NATURAL RESOURCES
 BUREAU OF LAND & WATER RESOURCES

If well telescopes please sketch and show depths.

GROUND LEVEL

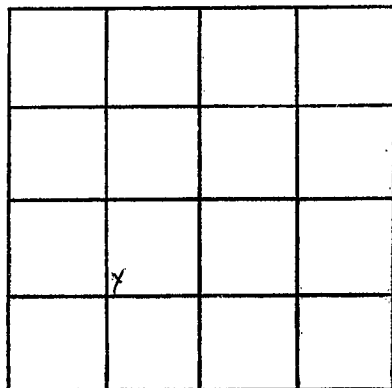

SECTION 17

Please indicate well location X.

ADDITIONAL INFORMATION

If more than one screen, show locations of each on sketch.