

Sunflower  
F 64  
5/9/81

MISSISSIPPI DEPARTMENT OF NATURAL RESOURCES  
Bureau of Land and Water Resources <sup>20</sup>  
Southport Mall  
P.O. Box 10631  
Jackson, Mississippi 39209  
WATER WELL DRILLERS LOG

CODED

May 09, 1981 date well completed  
Lanny's well & pump firm name  
Sunflower county well located

LANDOWNER: Bob Blackwood  
  
Drew, ms  
(mailing address)

description of formations encountered	from	to
Clay	0	28
Fine Sand	28	50
Coarse Sand	50	100

WELL LOCATION:  
sec. 18 T 22 N R 3 E  
2 miles S of Drew  
(distance) (direction) (nearest town)

WELL PURPOSE: test land  
(home, irrigation, municipal, industrial)

- WELL COMPLETION DATA:
- (1) diameter (inches) 8"
  - (2) total depth (feet) 100'
  - (3) static water level (feet) 20 below above top of ground.
  - (4) casing Plastic, 60'  
(material) (depth)  
(size) if telescope see back.
  - (5) screen 40', 60'  
(length) (depth to top)  
8", Plastic  
(size) (material)
  - (6) pump 30 1200  
(HP) (yield gpm)  
(type power)
  - (7) electric log No  
(yes or no)  
(organization running log)
  - (8) how well bottom plugged PVC cap

CODED

DEPT. OF NATURAL RESOURCES  
BUREAU OF LAND & WATER RESOURCES


OCT 15 1981

RECEIVED

DRILLERS REMARKS:

If well telescopes please sketch and show depths.

GROUND LEVEL

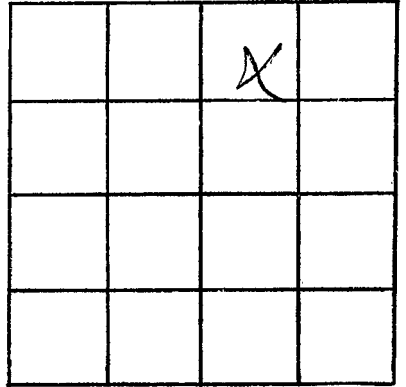

SECTION 18

Please indicate well location X.

ADDITIONAL INFORMATION

If more than one screen,  
show locations of each on sketch.