

Sunflower
CL-1712
WELL #2
F 65
4-16-81

MISSISSIPPI DEPARTMENT OF NATURAL RESOURCES
Bureau of Land and Water Resources
Southport Mall
P.O. Box 10631
Jackson, Mississippi 39209
WATER WELL DRILLERS LOG

CODED

4-16 19 81 LAYNE-CENTRAL COMPANY SUNFLOWER
date well completed firm name county well located

LANDOWNER:	description of formations encountered	from	to
<u>Fletcher Clark, Jr.</u>		clay	0
<u>Drew, MS</u>	fine sand	37	43
<u>(mailing address)</u>	coarse sand & gravel	43	55
<u>WELL LOCATION:</u>	coarse sand	55	66
<u>sec. 13 T 22 N R 3 E</u>	coarse sand & pea gravel	66	72
<u>5</u> miles <u>N.E.</u> of <u>Fishers</u>	coarse sand	72	95
(distance) (direction) (nearest town)	med. coarse sand	95	103
	coarse sand & gravel	103	120

WELL PURPOSE: irrigation
(home, irrigation, municipal, industrial)

WELL COMPLETION DATA:

- (1) diameter (inches) 32"
- (2) total depth (feet) 116'
- (3) static water level (feet) 27' 7" below above top of ground.
- (4) casing steel 66'
(material) (depth)
16" if telescope see back.
(size)
- (5) screen 50' 66'
(length) (depth to top)
16" st. steel
(size) (material)
- (6) pump 60 2500
(HP) (yield gpm)
diesel
(type power)
- (7) electric log no
(yes or no)
(organization running log)
- (8) how well bottom plugged st. plate

CODED


DRILLERS REMARKS: _____

DEPT. OF NATURAL RESOURCES
BUREAU OF LAND & WATER RESOURCES

RECEIVED
OCT 20 1981

If well telescopes please
sketch and show depths.

GROUND LEVEL

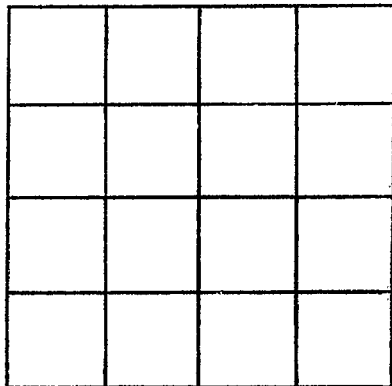

SECTION _____

Please indicate well location X.

ADDITIONAL INFORMATION

If more than one screen,
show locations of each on sketch.