

~~SUNFLOWER~~  
 CL-1691  
 F 66  
 4-1781

MISSISSIPPI DEPARTMENT OF NATURAL RESOURCES  
 Bureau of Land and Water Resources  
 Southport Mall  
 P.O. Box 10631  
 Jackson, Mississippi 39209  
 WATER WELL DRILLERS LOG

30  
 CODED

4-17 19 81 LAYNE-CENTRAL COMPANY SUNFLOWER  
 date well completed firm name county well located

LANDOWNER:	description of formations encountered	from	to
Fletcher Clark, Jr.	clay	0	14
Ruleville, MS (mailing address)	med. sand	14	22
	coarse sand	22	32
	coarse sand	32	42
WELL LOCATION:	coarse sand-pea gravel	42	52
sec. 5 T 22 N R 3 E S W	coarse sand-pea gravel	52	72
5 miles N.E. of Ruleville (distance) (direction) (nearest town)	coarse sand & gravel	72	82
	coarse sand & gravel	82	102
WELL PURPOSE: irrigation (home, irrigation, municipal, industrial)	coarse sand & gravel	102	109
	clay	109	112
WELL COMPLETION DATA:			
(1) diameter (inches) 32"			
(2) total depth (feet) 109'			
(3) static water level (feet) 27' <sup>below</sup> above top of ground.			
(4) casing steel 59' (material) (depth) 16" (size) if telescope see back.			
(5) screen 50' 59' (length) (depth to top) 16" st. steel (size) (material)			
(6) pump 60 2500 (HP) (yield gpm) Diesel (type power)			
(7) electric log no. (yes or no) (organization running log)			
(8) how well bottom plugged st. plate			
DRILLERS REMARKS:			


CODED.

DEPT. OF NATURAL RESOURCES  
 BUREAU OF LAND & WATER RESOURCES

OCT 20 1981  
 RECEIVED

If well telescopes please sketch and show depths.

GROUND LEVEL

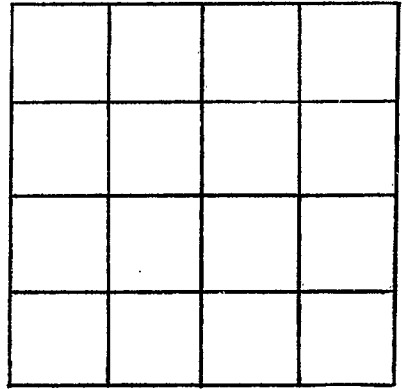

SECTION \_\_\_\_\_

Please indicate well location X.

ADDITIONAL INFORMATION

If more than one screen,  
show locations of each on sketch.