

SUNFLOWER

F 68

7/1/81

MISSISSIPPI
 BOARD OF WATER COMMISSIONERS
 416 North State Street
 Jackson, Mississippi 39201 CODED

WATER WELL DRILLERS LOG

July 81 19
date well completed

Cook Drilling
firm name

Sunflower
county well located

LANDOWNER:

Mad Hilder
Rubeville miss
(mailing address)

description of formations encountered

from to

Clay	Top	35'
Sand	35'	65'
Sand & gravel	65'	123'

WELL LOCATION:

sec. 13 T 22 N R 3 E
 1/4 miles NE of Rubeville
 (distance) (direction) (nearest town)

WELL PURPOSE:

(home, irrigation, municipal, industrial)

WELL COMPLETION DATA:

- (1) diameter (inches) 16"
- (2) total depth (feet) 123'
- (3) static water level (feet) 28' below top of ground
- (4) casing Steel 83' (material) (depth)
 16" if telescope see back. (size)
- (5) screen 16" 83' (length) (depth to top)
 16" Steel (size) (material)
- (6) pump 60 3000 (HP) (yield gpm)
 Diesel (type power)
- (7) electric log no (yes or no)
- (organization running log)
- (8) how well bottom plugged Steel

DEPT. OF NATURAL RESOURCES
 BUREAU OF LAND & WATER RESOURCES


NOV 6 1981

RECEIVED

DRILLERS REMARKS:

If well telescopes please sketch and show depths.

GROUND LEVEL

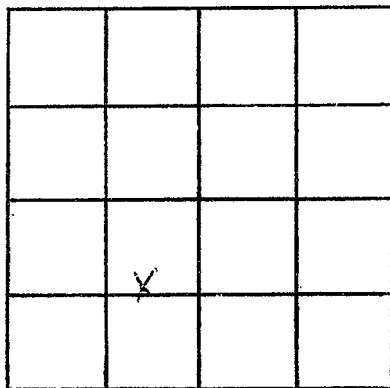

SECTION 13

Please indicate well location X.

ADDITIONAL INFORMATION

If more than one screen,
show locations of each on sketch.