

SUNFLOWER

CL-2151

F 70

9/28/82

MISSISSIPPI DEPARTMENT OF NATURAL RESOURCES

Bureau of Land and Water Resources

Southport Mall

P.O. Box 10631

Jackson, Mississippi 39209

WATER WELL DRILLERS LOG

CODED

9-28 1982
date well completed

1982

Layne-Central Co.
firm name

Sunflower

county well located

LANDOWNER:

City of Drew

Drew, MS

(mailing address)

WELL LOCATION:

sec. 6 T 22 N R 3 W

Drew

(distance) miles (direction) of (nearest town)

WELL PURPOSE: municipal
(home, irrigation, municipal, industrial)

WELL COMPLETION DATA:

- (1) diameter (inches) 20"
- (2) total depth (feet) 1318' 4"
- (3) static water level (feet) 18' below top of ground.
- (4) casing steel 1230' (material), (depth) 12" (size) if telescope see back.
- (5) screen 60' 9" 1238' 10" (length), (depth to top) 8" (size) st. steel (material)
- (6) pump 75 750 (HP), (yield gpm) electric (type power)
- (7) electric log yes (yes or no)
Layne-Hydrology Div.
(organization running log)
Backpressure
- (8) how well bottom plugged Valve

description of formations encountered

from

to

clay	0	38
sand	38	77
coarse sand & pea gravel	77	95
coarse sand & gravel	95	153
clay	153	160
sand & lignite	160	236
clay	236	250
sand	250	294
clay	294	505
sand & stks. of sandyclay	505	609
clay	609	680
rock	680	681
clay	681	780
sandy clay	780	862
clay	862	904
sandy clay & stk. of sand	904	981
clay	981	1230
sand & clay stks.	1230	1254
clay	1254	1274
sand	1274	1314
clay	1314	1403

1239
61
00

DEPT. OF NATURAL RESOURCES
BUREAU OF LAND & WATER RESOURCES


DEC 16 1982

RECEIVED

DRILLERS REMARKS:

If well telescopes please sketch and show depths.

GROUND LEVEL

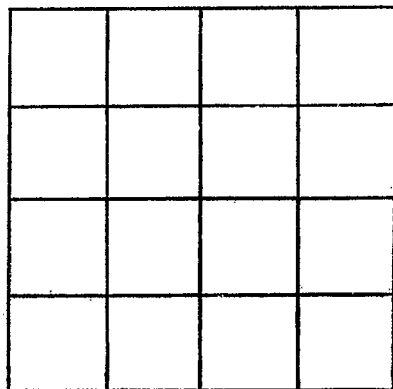

SECTION _____

Please indicate well location X.

ADDITIONAL INFORMATION

If more than one screen,
show locations of each on sketch.