

**MISSISSIPPI DEPARTMENT OF NATURAL RESOURCES**  
**Bureau of Land and Water Resources**  
 Southport Mall  
 P.O. Box 10631  
 Jackson, Mississippi 39209  
**WATER WELL DRILLERS LOG**

Sunflower  
F 71  
9/16/82

Sep. 16 19 82 Bruce Berryman Sunflower  
 date well completed firm name county well located  
Greenwood

**LANDOWNER:** Tommy Mahan  
248 S. Third Street,  
Drew. MS 38737  
 (mailing address)

**WELL LOCATION:**  
 sec. 10 T. 22 N R. 3 E  
S W  
4 miles SE of Drew  
 (distance) (direction) (nearest town)

**WELL PURPOSE:** Home  
 (home, irrigation, municipal, industrial)

**WELL COMPLETION DATA:**

- (1) diameter (inches) 4" x 2"  
 (2) total depth (feet) 933'  
 (3) static water level (feet) 916' below top of ground  
4 Blk. - 126'  
 (4) casing 2" Galv. - 787'  
 (material) (depth)  
         if telescope see back.  
 (size)  
 (5) screen 20' 913'  
 (length) (depth to top)  
2" .010 Stainless steel.  
 (size) (material)  
 (6) pump 1 1/2 30  
 (HP) (yield gpm)  
Electric  
 (type power)  
 (7) electric log NO  
 (yes or no)

          
 (organization running log)

(8) how well bottom plugged B.P.V.

DRILLERS REMARKS:

description of formations encountered	from	to
Clay	0	40
Sand	40	60
Sand & gravel	60	180
Sand	180	200
Clay	200	240
Shale	240	400
Clay	400	460
Sand	460	540
Clay	540	580
Rock	570	
Shale, rock & grn. sand.	580	640
Brown sand.	640	660
Shale & rock	660	720
Sandy shale	720	760
Clay	760	780
Shale & rock	780	800
Shale	800	900
Sand	900	930
Shale	930	950

**CODED**


DEPT. OF NATURAL RESOURCES  
 BUREAU OF LAND & WATER RESOURCES

FEB - 7 1983

**RECEIVED**

If well telescopes please sketch and show depths.

GROUND LEVEL

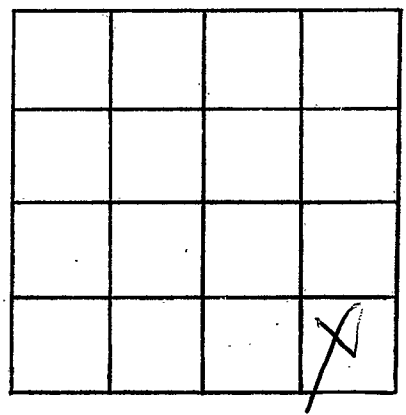

SECTION 10

Please indicate well location X.

ADDITIONAL INFORMATION

A series of horizontal lines for writing additional information.

If more than one screen, show locations of each on sketch.