

MISSISSIPPI DEPARTMENT OF NATURAL RESOURCES

Bureau of Land and Water Resources

Southport Mall

P.O. Box 10631

Jackson, Mississippi 39209

WATER WELL DRILLERS LOG

CODED

Sumner
F72
2115182

2115 1982 date well completed Nyer Well firm name Sumner county well located

LANDOWNER: <u>Rand</u>	description of formations encountered	from	to
(mailing address)	<u>Clay</u>	<u>0</u>	<u>18</u>
WELL LOCATION: sec. <u>16</u> T <u>22</u> (N) R <u>3</u> (E) (W) <u>6</u> miles <u>NE</u> of <u>Ruler</u>	<u>fine sand</u>	<u>18</u>	<u>28</u>
WELL PURPOSE: (home, irrigation, municipal, industrial)	<u>sand</u>	<u>28</u>	<u>46</u>
WELL COMPLETION DATA:	<u>sand & gravel</u>	<u>46</u>	<u>93</u>
(1) diameter (inches) <u>10"</u>			
(2) total depth (feet) <u>93</u>			
(3) static water level (feet) <u>18</u> below top of ground.			
(4) casing <u>Steel</u> <u>53</u> (material), (depth) <u>10"</u> (size) if telescope see back.			
(5) screen <u>20'</u> <u>53</u> (length), (depth to top) <u>10"</u> (size), <u>mill steel</u> (material)			
(6) pump <u>10</u> (HP) <u>680</u> (yield gpm) <u>electric</u> (type power)			
(7) electric log <u>NO</u> (yes or no)			
(8) how well bottom plugged <u>Plate</u>			
DRILLERS REMARKS:			


DEPT. OF NATURAL RESOURCES
BUREAU OF LAND & WATER RESOURCES

JUN 30 1982

RECEIVED

If well telescopes please sketch and show depths.

GROUND LEVEL

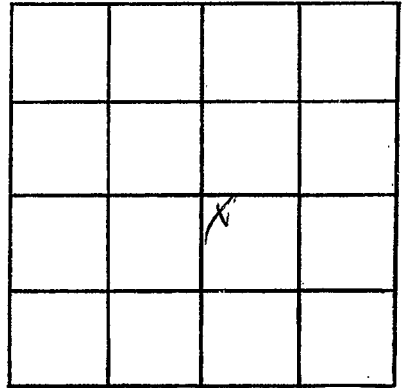

SECTION 16

Please indicate well location X.

ADDITIONAL INFORMATION

If more than one screen,
show locations of each on sketch.