

MISSISSIPPI DEPARTMENT OF NATURAL RESOURCES
 Bureau of Land and Water Resources
 Southport Mall
 P.O. Box 10631
 Jackson, Mississippi 39209
WATER WELL DRILLERS LOG

CODED

Sunflower
F 72
4115182

4-15-82 19 Moore's Well Drilling Service Sunflower
 date well completed firm name county well located

LANDOWNER: David A Woods
P.O. Box 52
Oren Miss
 (mailing address)

description of formations encountered	from	to
<u>Topsoil & Clay</u>	<u>1'</u>	<u>9'</u>
<u>Clay and Subsoil Sand</u>	<u>9'</u>	<u>18'</u>
<u>Small hd grain sand</u>	<u>18'</u>	<u>32'</u>
<u>Small gravel sand</u>	<u>32'</u>	<u>96'</u>
<u>Table Mineral</u>	<u>96'</u>	<u>97'</u>
<u>bottom of water table</u>		

WELL LOCATION:
 sec. 8 T 22 N R 3 E
 S W
1 miles South of Oren
 (distance) (direction) (nearest town)

WELL PURPOSE:
 (home, irrigation, municipal, industrial)

WELL COMPLETION DATA:

(1) diameter (inches) 6"

(2) total depth (feet) 97'

(3) static water level (feet) 18' below above top of ground.

(4) casing PVC 56'
 (material) (depth)
 (size) if telescope see back.

(5) screen 40' 9
 (length) (depth to top)
6" PVC
 (size) (material)

(6) pump 10 500
 (HP) (yield gpm)
Electric
 (type power)

(7) electric log No
 (yes or no)

(organization running log)

(8) how well bottom plugged PVC Cap

DRILLERS REMARKS:


MISSISSIPPI DEPARTMENT OF NATURAL RESOURCES
 BUREAU OF LAND & WATER RESOURCES

APR 27 1982

RECEIVED

If well telescopes please sketch and show depths.

GROUND LEVEL

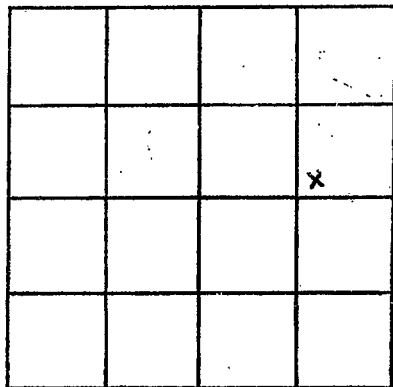

SECTION _____

Please indicate well location X.

ADDITIONAL INFORMATION

If more than one screen,
show locations of each on sketch.