

MISSISSIPPI DEPARTMENT OF NATURAL RESOURCES

Bureau of Land and Water Resources

Southport Mall

P.O. Box 10631

Jackson, Mississippi 39209

WATER WELL DRILLERS LOG

CODED

F 75
SUNFLOWER
3-30-84

Mar. 30 1984 Delta Well Sunflower
 date well completed firm name county well located

LANDOWNER:	description of formations encountered	from	to
Marlow & Sons			
Rule well Mrs	blue sand	18	30
(mailing address)	Course sand & Pla	30	95
	ground		
WELL LOCATION:	Course sand & large	95	110
sec. 27 T. 32 N. R. 3 E.	Ground		
3 miles N.E. of Rulewell			
(distance) (direction) (nearest town)			
WELL PURPOSE: Longation			
(home, irrigation, municipal, industrial)			
WELL COMPLETION DATA:			
(1) diameter (inches) 10"			
(2) total depth (feet) 110			
(3) static water level (feet) 34 below above top of ground.			
(4) casing Steel (material) (depth) (size) if telescope see back.			
(5) screen 40' (length) (depth to top) 10" (size) Steel (material)			
(6) pump 30 (HP) 1500 (yield gpm) Diesel (type power)			
(7) electric log No (yes or no)			
(organization running log)			
(8) how well bottom plugged Steel Plug			
DRILLERS REMARKS:			

DEPT. OF NATURAL RESOURCES
 BUREAU OF LAND & WATER RESOURCES

APR 30 1984

RECEIVED

If well telescopes please sketch and show depths.

GROUND LEVEL


Water level

30'

10' casing

100' 2" Screen

110' H.

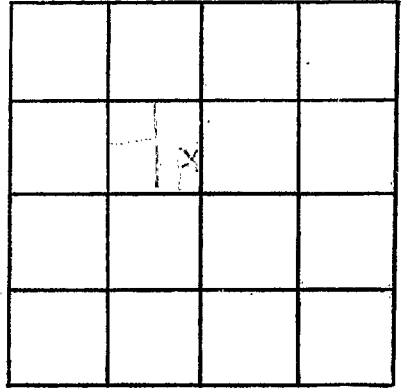

SECTION 27

Please indicate well location X.

ADDITIONAL INFORMATION

If more than one screen, show locations of each on sketch.