

MISSISSIPPI DEPARTMENT OF NATURAL RESOURCES
Bureau of Land and Water Resources
 Southport Mall
 P.O. Box 10631
 Jackson, Mississippi 39209
WATER WELL DRILLERS LOG

SUNFLOWER
 CL-2741 F-77

CODED

5-18 19 84 LAYNE-CENTRAL, CO. SUNFLOWER
 date well completed firm name county well located

LANDOWNER:
 Fletcher Clark, Jr.
 Drew, MS
 (mailing address)

description of formations encountered	from	to
	clay	0
sand	14	35
pea gravel sand	35	110

WELL LOCATION:
 sec. 13 T. 22 N R. 3 W
5 miles NE of Ruleville
 (distance) (direction) (nearest town)

WELL PURPOSE: irrigation
 (home, irrigation, municipal, industrial)

- WELL COMPLETION DATA:**
- (1) diameter (inches) 32"
 - (2) total depth (feet) 110'
 - (3) static water level (feet) 28' below top of ground.
 - (4) casing steel, 60'
 (material) (depth)
16" if telescope see back.
 (size)
 - (5) screen 50', 60'
 (length) (depth to top)
16", st. steel
 (size) (material)
 - (6) pump 60 2800
 (HP) (yield gpm)
electric
 (type power)
 - (7) electric log no
 (yes or no)
(organization running log)
 - (8) how well bottom plugged st. plate

CODED

DRILLERS REMARKS:


DEPT. OF NATURAL RESOURCES
 BUREAU OF LAND & WATER RESOURCES

SEP 21 1984

RECEIVED

If well telescopes please sketch and show depths.

GROUND LEVEL

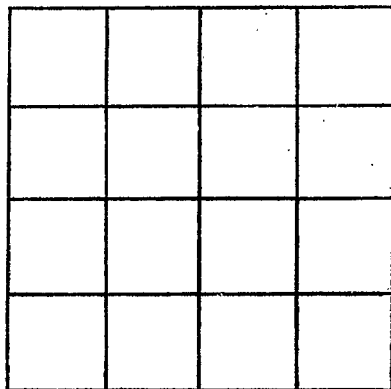

SECTION _____

Please indicate well location X.

ADDITIONAL INFORMATION

If more than one screen, show locations of each on sketch.