

MISSISSIPPI DEPARTMENT OF NATURAL RESOURCES
Bureau of Land and Water Resources

Southport Mall

P.O. Box 10631

Jackson, Mississippi 39209

CODED

WATER WELL DRILLERS LOG

F78
Sunflower
9-15-84

9/18/84
date well completed

Powell Irrigation
firm name

Sunflower
county well located

LANDOWNER:
Prudential Ins

(mailing address)

description of formations encountered	from	to
CLAY	0	20
Fine & Coarse Sand	20	50
Coarse Sand & Gravel	50	110

WELL LOCATION:
sec. 19 T 22 N R 3 E
S W
3 miles N of Bukville
(distance) (direction) (nearest town)

WELL PURPOSE: IRRIGATION
(home, irrigation, municipal, industrial)

WELL COMPLETION DATA:

(1) diameter (inches) 16

(2) total depth (feet) 110

(3) static water level (feet) 30 below above top of ground.

(4) casing Steel 70
(material) (depth)

(size) if telescope see back.

(5) screen 40 70
(length) (depth to top)
16 Steel
(size) (material)

(6) pump 60 2000
(HP) (yield gpm)
Diesel
(type power)

(7) electric log No
(yes or no)

(organization running log)

(8) how well bottom-plugged
Steel Plate

DRILLERS REMARKS:


DEPT. OF NATURAL RESOURCES
BUREAU OF LAND & WATER RESOURCES

NOV 29 1984

RECEIVED

If well telescopes please
sketch and show depths.

GROUND LEVEL

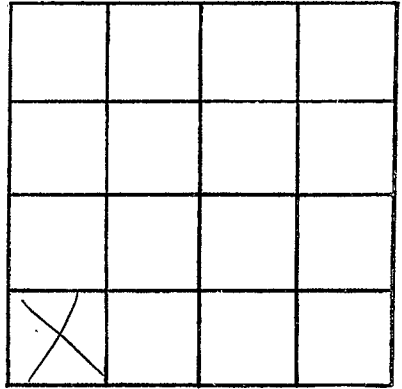

SECTION 19

Please indicate well location X.

ADDITIONAL INFORMATION

If more than one screen,
show locations of each on sketch.