

MISSISSIPPI DEPARTMENT OF NATURAL RESOURCES

Bureau of Land and Water Resources

Southport Mall

P.O. Box 10631

Jackson, Mississippi 39209

WATER WELL DRILLERS LOG

CODED

FR  
Sunflower  
9-15-84

9/84 19 Power IRRIGATION Sunflower  
date well completed firm name county well located

LANDOWNER:  
Prudential TMS  
(mailing address)

description of formations encountered	from	to
<u>Clay</u>	<u>0</u>	<u>20</u>
<u>Med SAND</u>	<u>20</u>	<u>50</u>
<u>COARSE SAND &amp; CLAY</u>	<u>50</u>	<u>100</u>

WELL LOCATION:  
sec 30T-22N R 3E  
1/2 miles <sup>S</sup> NW of Riverville  
(distance) (direction) (nearest town)

WELL PURPOSE: IRRIGATOR  
(home, irrigation, municipal, industrial)

WELL COMPLETION DATA:

(1) diameter (inches) 16

(2) total depth (feet) 100

(3) static water level (feet) 25 below above top of ground.

(4) casing Steel, 60,  
(material) (depth)  
         if telescope see back.  
(size)

(5) screen 40, 60  
(length) (depth to top)  
16, Steel  
(size) (material)

(6) pump 60, 2000  
(HP) (yield gpm)  
Diesel  
(type power)

(7) electric log NO  
(yes or no)  
         (organization running log)

(8) how well bottom plugged Steel Plate

DRILLERS REMARKS:  
MS-GW 9953


DEPT. OF NATURAL RESOURCES  
BUREAU OF LAND & WATER RESOURCES  
MISSISSIPPI

NOV 20 1984

RECEIVED

If well telescopes please  
sketch and show depths.

GROUND LEVEL

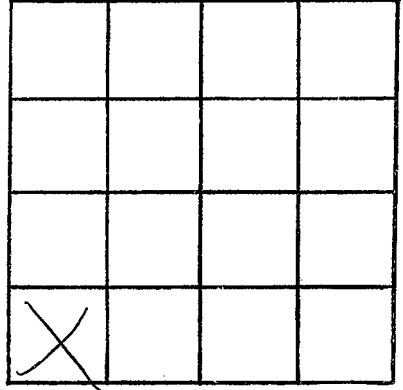

SECTION 20

Please indicate well location X.

ADDITIONAL INFORMATION

If more than one screen,  
show locations of each on sketch.