

MISSISSIPPI DEPARTMENT OF NATURAL RESOURCES

Bureau of Land and Water Resources

Southport Mall

P.O. Box 10631

Jackson, Mississippi 39209

WATER WELL DRILLERS LOG

CODED

Sunflower  
F082

2-28-86

19 Irrigation Equipment

Sunflower

date well completed

firm name

county well located

LANDOWNER: Robert Blackwood

description of formations encountered

from to

Rt. 2, BOX 810

DREWIMS 38737

(mailing address)

CLAY	0	35
FINE SAND	35	45
COARSE SAND	45	85
COARSE SAND / GRAVEL	85	95

WELL LOCATION:

sec. 18 T. 22 S. R. 3 E.  
4 miles SW of DREW  
(distance) (direction) (nearest town)

CODED

WELL PURPOSE: FISH PONDS  
(home, irrigation, municipal, industrial)

WELL COMPLETION DATA:

- (1) diameter (inches) 16"
- (2) total depth (feet) 95'
- (3) static water level (feet) 25' below above top of ground.
- (4) casing steel, 55'  
(material) (depth)  
16" if telescope see back.  
(size)
- (5) screen 40', 55'  
(length) (depth to top)  
16" STEEL  
(size) (material)
- (6) pump 40, 2000  
(HP) (yield gpm)  
Electric  
(type power)
- (7) electric log NO  
(yes or no)  
(organization running log)
- (8) how well bottom plugged steel  
PLATE

RECEIVED  
APR 10 1986


Department of Natural Resources  
Bureau of Land & Water Resources

DRILLERS REMARKS:

#86058 D5B01

If well telescopes please sketch and show depths.

GROUND LEVEL

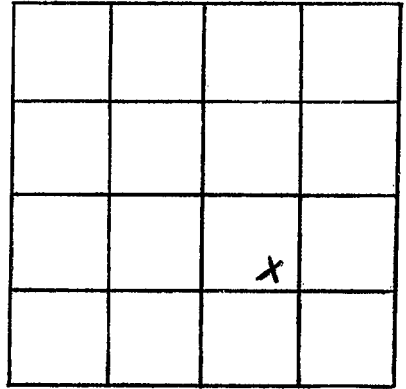

SECTION 18

Please indicate well location X.

ADDITIONAL INFORMATION

If more than one screen,  
show locations of each on sketch.