

MISSISSIPPI DEPARTMENT OF NATURAL RESOURCES

Bureau of Land and Water Resources

Southport Mall

P.O. Box 10631

Jackson, Mississippi 39209

WATER WELL DRILLERS LOG

CODED

SUNFLOWER  
F083

3-4-86

IRRIGATION EQUIPMENT

SUNFLOWER

date well completed

firm name

county well located

LANDOWNER: Robert Blackwood

Rt. 2, BOX 810

Drew, MS 38737

(mailing address)

description of formations encountered

from

to

CLAY

0 35

FINE SAND

35 55

COARSE SAND

55 65

FINE SAND

65 90

COARSE SAND / pea gravel

90 110

WELL LOCATION:

sec. 18 T 22 N R 3  
S W E  
4 miles SW of Drew  
(distance) (direction) (nearest town)

WELL PURPOSE: FISH PONDS  
(home, irrigation, municipal, industrial)

WELL COMPLETION DATA:

- (1) diameter (inches) 16"
- (2) total depth (feet) 110
- (3) static water level (feet) 25 below above top of ground.
- (4) casing steel 70'  
(material) (depth)  
16" if telescope see back.  
(size)
- (5) screen 40' 70'  
(length) (depth to top)  
16" steel  
(size) (material)
- (6) pump 60 3000  
(HP) (yield gpm)  
Electric  
(type power)
- (7) electric log NO  
(yes or no)

(organization running log) steel plate

(8) how well bottom plugged

RECEIVED  
MAY 10 1986  
APR 11 1986


DRILLERS REMARKS:

# 86058 05 B02

Department of Natural Resources  
Bureau of Land and Water Resources

If well telescopes please sketch and show depths.

GROUND LEVEL

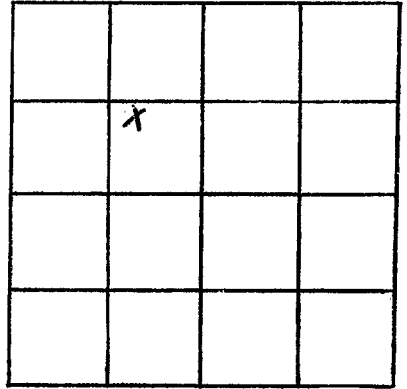

SECTION 18

Please indicate well location X.

ADDITIONAL INFORMATION

If more than one screen,  
show locations of each on sketch.