

MISSISSIPPI DEPARTMENT OF NATURAL RESOURCES

Bureau of Land and Water Resources

Southport Mall

P.O. Box 10631

Jackson, Mississippi 39209

WATER WELL DRILLERS LOG

CODED

SUNFLOWER
F 84

5/6 1984 Jb K IRRISATE Sun Flower
date well completed firm name county well located

LANDOWNER: Mrs. W. D. Kent

description of formations encountered

from to

CLAY 0 23

(mailing address)

FINE SAND 23 36

WELL LOCATION:

sec. 32 T. 22 N R. 3 E W
1/2 miles E of Rollville
(distance) (direction) (nearest town)

SAND gravel 36 117

WELL PURPOSE:

(home, irrigation, municipal, industrial)


WELL COMPLETION DATA:

- (1) diameter (inches) 10
- (2) total depth (feet) 117
- (3) static water level (feet) 24 below top of ground.
- (4) casing (material) PVC (depth) 77
10 (size) If telescope see back.
- (5) screen 40 (length) 77 (depth to top)
10 (size) PVC (material)
- (6) pump 10 (HP) 750 (yield gpm)
Electric (type power)
- (7) electric log NO (yes or no)

(organization running log)

- (8) how well bottom plugged CAP

CODED

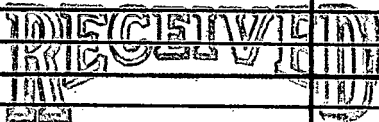


MAY 29 1986

Department of Natural Resources
Bureau of Land & Water Resources

DRILLERS REMARKS:

If well telescopes please sketch and show depths.

GROUND LEVEL

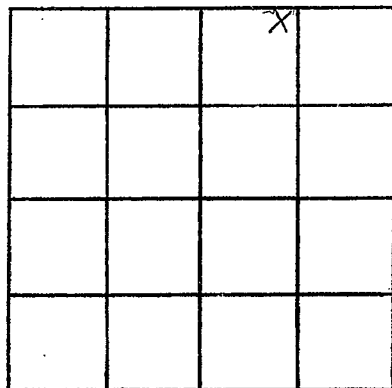

SECTION 32

Please indicate well location X.

ADDITIONAL INFORMATION

If more than one screen,
show locations of each on sketch.