

MISSISSIPPI DEPARTMENT OF NATURAL RESOURCES

Bureau of Land and Water Resources

Southport Mall

P.O. Box 10631

Jackson, Mississippi 39209

WATER WELL DRILLERS LOG

CODED

SUNFLOWER
F 85

4-2-86
date well completed

Ray's Pump Well Inc.
firm name

SUNFLOWER
county well located

LANDOWNER:	description of formations encountered	from	to
Emmanuel Mabon			
Rt. 1			
Drew, Miss (mailing address)	clay	0	15
	FINE SAND	15	30
	COARSE SAND / pea gravel	30	103
WELL LOCATION:			
sec. 3 T. 22 N. R. 3 E. S. W.			
2 miles E of Drew (distance) (direction) (nearest town)			
WELL PURPOSE:			
(home, irrigation, municipal, industrial)			
WELL COMPLETION DATA:			
(1) diameter (inches) 16"			
(2) total depth (feet) 103			
(3) static water level (feet) _____ below above top of ground.			
(4) casing steel 63' (material) (depth) 16" (size) if telescope see back.			
(5) screen 40' 63' (length) (depth to top) 16" steel (size) (material)			
(6) pump 60 3000 (HP) (yield gpm) Dsl (type power)			
(7) electric log NO (yes or no)			
(organization running log)			
(8) how well bottom plugged steel plate			
DRILLERS REMARKS:			


CODED

RECEIVED
AUG 26 1986

Department of Natural Resources
Bureau of Land & Water

If well telescopes please sketch and show depths.

GROUND LEVEL

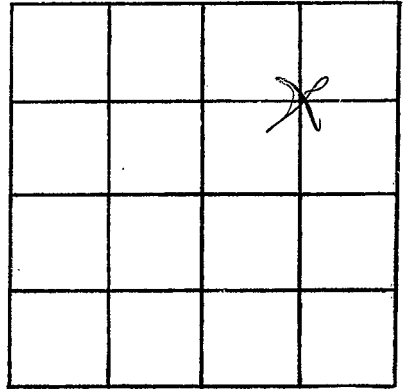

SECTION _____

Please indicate well location X.

ADDITIONAL INFORMATION

If more than one screen,
show locations of each on sketch.