

MISSISSIPPI DEPARTMENT OF NATURAL RESOURCES

Bureau of Land and Water Resources

Southport Mall

P.O. Box 10631

Jackson, Mississippi 39209 **CODED**

**WATER WELL DRILLERS LOG**

SUNFLOWER  
F 86

8/86 19 Powell str Sunflower  
 date well completed firm name county well located

LANDOWNER:  
Prudential str  
Memphis, Jr  
 (mailing address)

description of formations encountered	from	to
<u>Clay</u>	<u>0</u>	<u>23</u>
<u>Fine sand</u>	<u>23</u>	<u>53</u>
<u>Coarse sand &amp; gravel</u>	<u>53</u>	<u>123</u>

WELL LOCATION:  
 sec 30 T 22 N R 3 E  
3 miles N of Ridgely  
 (distance) (direction) (nearest town)

WELL PURPOSE: str  
 (home, irrigation, municipal, industrial)

- WELL COMPLETION DATA:
- (1) diameter (inches) 16
  - (2) total depth (feet) 123
  - (3) static water level (feet) 25 below above top of ground.
  - (4) casing steel, 83,  
 (material) (depth)  
 (size) if telescope see back.
  - (5) screen 40, 83  
 (length) (depth to top)  
16, steel  
 (size) (material)
  - (6) pump 60, 2200  
 (HP) (yield gpm)  
diesel  
 (type power)
  - (7) electric log no  
 (yes or no)  
 (organization running log)
  - (8) how well bottom plugged  
steel plate

**CODED**

**RECEIVED**


OCT 27 1986

Department of Natural Resources  
 Bureau of Land & Water Resources

DRILLERS REMARKS:  
replacement well  
old well next to it

If well telescopes please  
sketch and show depths.

GROUND LEVEL

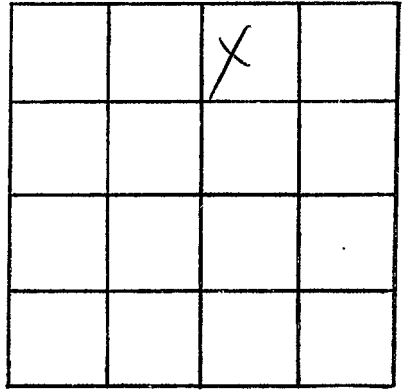

SECTION 30

Please indicate well location X.

ADDITIONAL INFORMATION

If more than one screen,  
show locations of each on sketch.