


MISSISSIPPI DEPARTMENT OF NATURAL RESOURCES
Bureau of Land and Water Resources
Southport Mall
P.O. Box 10631
Jackson, Mississippi 39209
WATER WELL DRILLERS LOG

SUNFLOWER
22-3660
7676
F 89

7-14 1987 LAYNE-CENTRAL CO. SUNFLOWER
date well completed firm name county well located

LANDOWNER:	description of formations encountered	from	to
F.T. CLARK FARMS	CLAY	0	63
DREW, MS	GRAVEL SAND	63	117
(mailing address)	GRAVEL BOULDERS	117	123
WELL LOCATION: sec. <u>13</u> T <u>22</u> N R <u>3</u> E <u>5</u> miles NE of RULEVILLE (distance) (direction) (nearest town)			
WELL PURPOSE: <u>IRRIGATION</u> (home, irrigation, municipal, industrial)			
WELL COMPLETION DATA:			
(1) diameter (inches)	<u>16"</u>		
(2) total depth (feet)	<u>123'</u>		
(3) static water level (feet)	<u>31'</u> below top of ground.		
(4) casing (material)	<u>STEEL</u>		
	(depth) <u>69'</u>		
	<u>16"</u> if telescope see back. (size)		
(5) screen (length)	<u>50'</u>		
	(depth to top) <u>69'</u>		
	(size) <u>16"</u>		
	(material) <u>ST. STEEL</u>		
(6) pump (HP)	<u>60</u>		
	(yield gpm) <u>2500</u>		
	(type power) <u>DIESEL</u>		
(7) electric log	<u>NO</u>		
	(yes or no)		
	(organization running log)		
(8) how well bottom plugged	<u>ST. PLATE</u>		
DRILLERS REMARKS:			

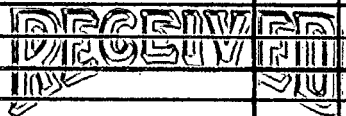


FFR 01 1983

Department of Natural Resources
Bureau of Land & Water Resources

If well telescopes please sketch and show depths.

GROUND LEVEL

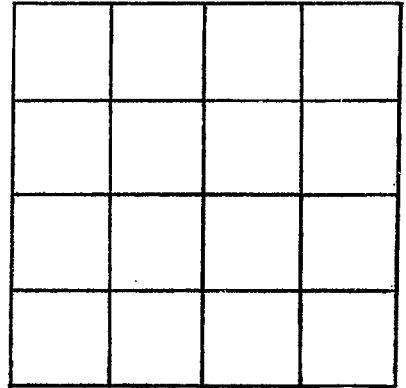

SECTION _____

Please indicate well location X.

ADDITIONAL INFORMATION

If more than one screen,
show locations of each on sketch.