

CODED  
 TEP09841  
 JLC-08-06-88  
 F 90  
 CODED

MISSISSIPPI DEPARTMENT OF NATURAL RESOURCES  
 Bureau of Land and Water Resources  
 Southport Mall  
 P.O. Box 10631  
 Jackson, Mississippi 39209  
 WATER WELL DRILLERS LOG

6-8 1988 Dyer Well Sunflower  
 date well completed firm name county well located

LANDOWNER: Mike Manning

description of formations encountered

from to

Drew Ms  
 (mailing address)

description of formations encountered	from	to
Clay	0	36
Sand	36	86
Sand & Gravel	86	90
Sand & Gravel	90	92
Sand & Gravel	92	110
Sand	110	120

WELL LOCATION:

sec. 9 T22N R3E  
 3 miles SE of Drew  
 (distance) (direction) (nearest town)

WELL PURPOSE: Irrigation  
 (home, irrigation, municipal, industrial)

WELL COMPLETION DATA:

- (1) diameter (inches) 10"
- (2) total depth (feet) 120'
- (3) static water level (feet) \_\_\_\_\_ below above top of ground.
- (4) casing steel (material) (depth) 10" (size) if telescope see back.
- (5) screen 40 (length) (depth to top) 10" (size) (material)
- (6) pump 20 (HP) (yield gpm)  
 Elec (type power)
- (7) electric log No (yes or no)  
 None (organization running log)
- (8) how well bottom plugged Plate

DRILLERS REMARKS:


RECEIVED

JUL 12 1988

Department of Natural Resources  
 Bureau of Land & Water Resources

If well telescopes please sketch and show depths.

GROUND LEVEL

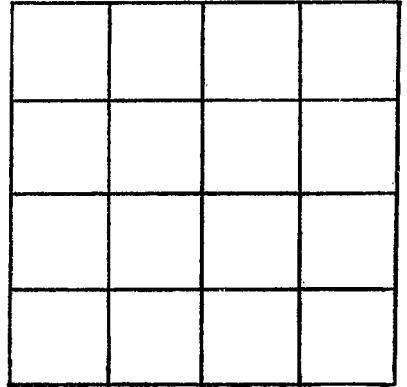

SECTION \_\_\_\_\_

Please indicate well location X.

ADDITIONAL INFORMATION

If more than one screen,  
show locations of each on sketch.