

33-45-58 90-28-23

MISSISSIPPI DEPARTMENT OF ENVIRONMENTAL QUALITY

Office of Land and Water Resources

COUNTY WELL LOCATED	
Sunflower	
WELL NUMBER	CODED
F-109	
DATE WELL COMPLETED	
3-28-02	

PERMIT NUMBER
NAME OF DRILLING FIRM
Irrigation Equipment Inc.
Indianola, MS

P. O. Box 10631  
Jackson, MS 39289-0631  
WATER WELL DRILLERS LOG

NAME & MAILING ADDRESS OF LANDOWNER			
Fletcher Clark			
3830 Hwy. 49			
Ruleville, MS 38771			
Latitude:			
Longitude:			
WELL LOCATION.	SEC	TOWNSHIP	RANGE
NE/NE	23	22N	N 3W E
DISTANCE	DIRECTION	NEAREST TOWN	
Miles	NE	Ruleville	
OTHER LANDMARK			
WELL PURPOSE: Home, Irrigation, Municipal, Industrial, Fish Pond, etc.			
Irrigation			

PUMP DATA

PUMP TYPE (Circle One):  
 Submersible,  Turbine,  Jet,  Flowing Well,  
 Other (Describe) \_\_\_\_\_

POWER TYPE (Circle One):  
 Electric,  Tractor,  Diesel,  Gasoline,  Butane,  
 Other (Describe) \_\_\_\_\_ H/P 15

DESCRIPTION OF FORMATIONS ENCOUNTERED	FROM	TO
Clay	0	61
Clay/Med. Sand	61	75
Fine Sand	75	85
Med. Sand/gravel	85	115

WELL DATA		
Well Depth	Casing Diameter (In.)	Casing Length (Ft.)
115	10	85
Type of Casing	Hole Depth	Depth to Static Water Level
pvc	115	
TYPE OF COMPLETION: (Circle One or More):		
<input checked="" type="checkbox"/> Gravel Packed, <input type="checkbox"/> Underreamed, <input type="checkbox"/> Telescoped, <input type="checkbox"/> Natural Development, <input type="checkbox"/> Open Hole, <input type="checkbox"/> Other (Describe) _____		

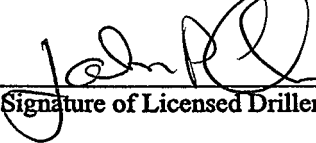
RECEIVED  
 JUL 22 2002  
 BY: OLWR

WELL GROUTED TO A DEPTH OF _____ FEET
Type Grout (circle one): Cement, Bentonite, or Mix

SCREEN DATA		
Diameter - Inches	Length - Feet	Slot Size - Inches
10	30	0.50
Screen Type	Depth to Bottom - Feet	
pvc	115	

Top of Lap Pipe or Reduction in Casing
FEET <input type="checkbox"/> IF TELESCOPED OR MORE THAN ONE SCREEN: USE BACK PAGE

I certify that the well was drilled, constructed and completed in accordance with all applicable Requirements of the Mississippi Department of Environmental Quality and/or the Mississippi Department of Health regulations and state laws.

  
 Signature of Licensed Driller and License No. 0439

7-17-02  
 Date

If well telescopes please sketch and show depths.

GROUND LEVEL

			X

SECTION 23

Please indicate well location X.

Pump Capacity (GPM)	No. of Stages	Setting Depth
750	1	70 FT.

PUMP TEST

Well yielded \_\_\_\_\_ GPM with  
a drawdown of \_\_\_\_\_ ft.  
after \_\_\_\_\_ hours of pumping

**LOG DATA**

TYPE OF LOG RUN (Circle One):      No Log Run,  
Electric, Gamma Ray, Density, Sonic, Neutron,  
Other (Describe) \_\_\_\_\_

Name of Organization Running Log

**GEOLOGIC DATA (Office Use Only)**

Surface Elev.	Geologic Unit	Unit Thickness	Depth to Top
Subs. SWL	Date	Analysis	Aquifer Test

Driller's Remarks

---



---



If more than one screen,  
show location of each on sketch.