

**MISSISSIPPI DEPARTMENT OF ENVIRONMENTAL QUALITY**

Office of Land and Water Resources

COUNTY WELL LOCATED  
**Sunflower**

WELL NUMBER **F-110** CODED

DATE WELL COMPLETED  
**3-28-02**

PERMIT NUMBER

NAME OF DRILLING FIRM  
**Irrigation Equipment Inc.**

**Indianola, MS**

P. O. Box 10631  
Jackson, MS 39289-0631  
**WATER WELL DRILLERS LOG**

NAME & MAILING ADDRESS OF LANDOWNER  
**Fletcher Clark**  
**3830 Hwy. 49**  
**Ruleville, MS 38771**

Latitude:  
Longitude:

WELL LOCATION: SEC TOWNSHIP RANGE  
**NW/SE 21 22N 3W**

DISTANCE DIRECTION NEAREST TOWN  
Miles **NE Ruleville**

OTHER LANDMARK

WELL PURPOSE: Home, Irrigation, Municipal, Industrial, Fish Pond, etc.  
**Irrigation**

**PUMP DATA**

PUMP TYPE (Circle One):  
Submersible, Turbine, Jet, Flowing Well,  
Other (Describe) \_\_\_\_\_

POWER TYPE (Circle One):  
Electric, Tractor, Diesel, Gasoline, Butane,  
Other (Describe) \_\_\_\_\_ H/P **15**

DESCRIPTION OF FORMATIONS ENCOUNTERED	FROM	TO
Clay	0	18
Fine Sand	18	55
Fine Sand/gravel	55	68
Med. Sand/gravel	68	75
Fine Sand	75	95
Med. Sand/gravel	95	125

**WELL DATA**

Well Depth <b>125</b>	Casing Diameter (In.) <b>10</b>	Casing Length (Ft.) <b>95</b>
Type of Casing <b>pvc</b>	Hole Depth <b>125</b>	Depth to Static Water Level <b>47ft.</b>

TYPE OF COMPLETION: (Circle One or More):  
Gravel Packed, Underreamed, Telescoped,  
Natural Development, Open Hole, Other  
(Describe) \_\_\_\_\_

WELL GROUTED TO A DEPTH OF \_\_\_\_\_ FEET  
Type Grout (circle one): Cement, Bentonite, or Mix

**SCREEN DATA**

Diameter - Inches <b>10</b>	Length - Feet <b>30</b>	Slot Size - Inches <b>.050</b>
Screen Type <b>pvc</b>	Depth to Bottom - Feet <b>125</b>	

**RECEIVED**

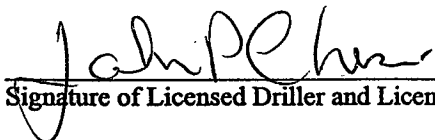
**JUL 22 2002**

**BY: OLWR**

Top of Lap Pipe or Reduction in Casing

FEET IF TELESCOPED OR MORE THAN ONE SCREEN: USE BACK PAGE

I certify that the well was drilled, constructed and completed in accordance with all applicable Requirements of the Mississippi Department of Environmental Quality and/or the Mississippi Department of Health regulations and state laws.

 **0439**  
Signature of Licensed Driller and License No.

**7-17-02**  
Date

**Additional Information Required On Back**

If well telescopes please sketch and show depths.

GROUND LEVEL

		X	

SECTION 21

Please indicate well location X.

Pump Capacity (GPM)	No. of Stages	Setting Depth
750	1	70 FT.

PUMP TEST

Well yielded \_\_\_\_\_ GPM with  
 a drawdown of \_\_\_\_\_ ft.  
 after \_\_\_\_\_ hours of pumping

**LOG DATA**

TYPE OF LOG RUN (Circle One):      No Log Run,  
 Electric, Gamma Ray, Density, Sonic, Neutron,  
 Other (Describe) \_\_\_\_\_

Name of Organization Running Log

**GEOLOGIC DATA (Office Use Only)**

Surface Elev.	Geologic Unit	Unit Thickness	Depth to Top
Subs. SWL	Date	Analysis	Aquifer Test

Driller's Remarks

---



---



If more than one screen,  
 show location of each on sketch.